

**WILKINSON**  
 G 2001  
 10-18-76

MISSISSIPPI  
 BOARD OF WATER COMMISSIONERS  
 416 North State Street  
 Jackson, Mississippi 39201

WATER WELL DRILLERS LOG

10-18 date well completed 1976 Rayboen Drilling & Const. Wilkinson firm name Wilkinson county well located


LANDOWNER:	description of formations encountered	from	to
Ray Patrick			
Baton Rouge, La. (mailing address)	grey clay	2	115
	sh. sand	115	145
	blue clay	145	240
	sand	240	280
<b>WELL LOCATION:</b>			
sec. 25 T. 3 N. R. 2 E. S. 1 W.			
8 miles N of Woodville			
<b>WELL PURPOSE:</b> Home (home, irrigation, municipal, industrial)			
<b>WELL COMPLETION DATA:</b>			
(1) diameter (inches) 2"			
(2) total depth (feet) 280'			
(3) static water level (feet) 126' below top of ground.			
(4) casing galv. 273' (material) (depth)			
2" (size) If telescope see back.			
(5) screen 5' 273' (length) (depth to top)			
2" 155" (size) (material)			
(6) pump 1 1/2 6 GPM (HP) (yield gpm)			
elec. (type power)			
(7) electric log no (yes or no)			
(organization running log)			
(8) how well bottom plugged Wood Pkg			
<b>DRILLERS REMARKS:</b>			

RECEIVED  
 FEB 10 1977

MISS. BD. OF WATER COMMISSIONERS

If well telescopes please sketch and show depths.

GROUND LEVEL

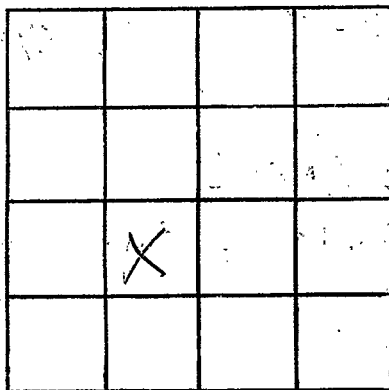

SECTION 25

Please indicate well location X.

ADDITIONAL INFORMATION

If more than one screen, show locations of each on sketch.