

WILKINSON
G 2000
4-17-80

MISSISSIPPI
BOARD OF WATER COMMISSIONERS
416 North State Street
Jackson, Mississippi 39201

WATER WELL DRILLERS LOG

April 17 1980 Reuss Miller Wilbur
date well completed firm name county well located

LANDOWNER:	description of formations encountered	from	to
<u>Wiley Carrin</u> <u>Rt. Woodville</u> (mailing address)	<u>clay</u> <u>soft ground</u>	<u>0</u>	<u>152</u>
WELL LOCATION: sec <u>31</u> T <u>3</u> N R <u>20</u> <u>5</u> miles <u>north</u> of <u>Woodville</u> (distance) (direction) (nearest town)	<u>blue chalk</u> <u>fine sand</u> <u>coarse sand</u>	<u>17</u> <u>28</u> <u>115</u>	<u>38</u> <u>115</u> <u>125</u> <u>143</u>
WELL PURPOSE: <u>Domestic</u> (home, irrigation, municipal, industrial)			
WELL COMPLETION DATA: (1) diameter (inches) <u>4"</u> (2) total depth (feet) <u>143</u> (3) static water level (feet) <u>61</u> below above top of ground. (4) casing <u>plastic bottom</u> (material) (depth) <u>2</u> If telescope see back. (size) (5) screen <u>10'</u> <u>133'</u> (length) (depth to top) <u>4"</u> <u>plastic</u> (size) (material) (6) pump <u>by Athess</u> (HP) (yield gpm) <u>1/2</u> (type power) (7) electric log <u>no</u> (yes or no) <u>-</u> (organization running log)			
(8) how well bottom plugged <u>Backhoe at Valve</u> DRILLERS REMARKS:			


DEPT. OF NATURAL RESOURCES
BUREAU OF LAND & WATER RESOURCES

JAN 12 1981

RECEIVED

If well telescopes please sketch and show depths.

GROUND LEVEL

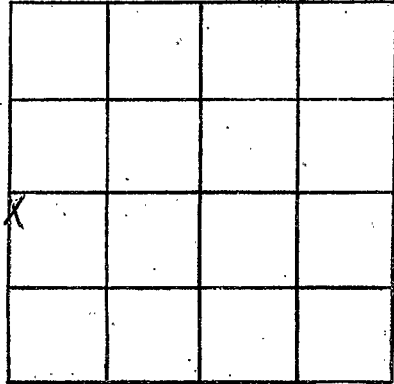

SECTION 51

Please indicate well location X.

ADDITIONAL INFORMATION

If more than one screen,
show locations of each on sketch.