

MISSISSIPPI DEPARTMENT OF NATURAL RESOURCES
Bureau of Land and Water Resources
 Southport Mall
 P.O. Box 10631
 Jackson, Mississippi 39209
WATER WELL DRILLERS LOG

Wilkinson
6
2905

3-16 1983 Robinson Drill & Tool Co. Wilkinson
 date well completed firm name county well located

LANDOWNER:	description of formations encountered	from	to
<i>Robert Jones</i>	<i>Top soil</i>	<i>0</i>	<i>4</i>
<i>Woodville, MS</i> (mailing address)	<i>Chalk</i>	<i>4</i>	<i>170</i>
WELL LOCATION:	<i>sand</i>	<i>170</i>	<i>250</i>
sec. <u>12</u> T. <u>3</u> N. R. <u>2</u> E.			
<u>4</u> miles <u>south</u> of <u>Delaware</u> (distance) (direction) (nearest town)			
WELL PURPOSE: <u>Private</u> (home, irrigation, municipal, industrial)			
WELL COMPLETION DATA:			
(1) diameter (inches) <u>4"</u>			
(2) total depth (feet) <u>250'</u>			
(3) static water level (feet) <u>190'</u> below above top of ground.			
(4) casing <u>PVC</u> , <u>240'</u> (material) (depth) <u>4"</u> (size) if telescope see back.			
(5) screen <u>10'</u> , <u>240'</u> (length) (depth to top)			
<u>4"</u> , <u>PVC</u> (size) (material)			
(6) pump <u>3/4</u> , <u>66gpm</u> (HP) (yield/gpm)			
<u>elec</u> (type power)			
(7) electric log <u>NO</u> (yes or no)			
(organization running log)			
(8) how well bottom plugged <u>wood plug</u>			
DRILLERS REMARKS:			


DEPT. OF NATURAL RESOURCES
 BUREAU OF LAND & WATER RESOURCES

MAR 21 1983

RECEIVED

If well telescopes please sketch and show depths.

GROUND LEVEL

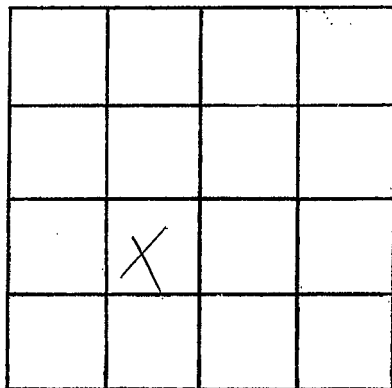

SECTION 12

Please indicate well location X.

ADDITIONAL INFORMATION

If more than one screen,
show locations of each on sketch.