

MISSISSIPPI DEPARTMENT OF NATURAL RESOURCES

Bureau of Land and Water Resources

Southport Mall

P.O. Box 10631

Jackson, Mississippi 39209

WATER WELL DRILLERS LOG

<u>Wilkinson</u>
<u>G 2000</u>
<u>4/26/83</u>

<u>April 26</u>	<u>19 83</u>	<u>Gretn Water Well</u>	<u>Wilkinson</u>
date well completed		firm name	county well located

LANDOWNER:	description of formations encountered	from	to
<u>B. J. Grace</u>			
<u>115 Sgt. Prentiss</u>	<u>Loess</u>	<u>7</u>	<u>10</u>
	<u>white clay</u>	<u>10</u>	<u>20</u>
<u>Natchez, Ms.</u>	<u>blue clay</u>	<u>20</u>	<u>185</u>
(mailing address)	<u>sand</u>	<u>185</u>	<u>235</u>

WELL LOCATION:

sec. 14 T. 3 (N) S. R. 2 (E) W.

8 miles N of Woodville

(distance) (direction) (nearest town)

WELL PURPOSE: home

(home, irrigation, municipal, industrial)

WELL COMPLETION DATA:

(1) diameter (inches) 4

(2) total depth (feet) 235

(3) static water level (feet) 300 below top of ground.

(4) casing PVC, 225 (material), (depth)

4" (size) if telescope see back.

(5) screen 10' (length), 225' (depth to top)

0.10 (size), PVC (material)

(6) pump 3/4 sub 8 (HP) (yield gpm)

electricity (type power)

(7) electric log no (yes or no)

(organization running log)

(8) how well bottom plugged back wash valve

DRILLERS REMARKS:


DEPT. OF NATURAL RESOURCES
BUREAU OF LAND & WATER RESOURCES

MAY 23 1983

RECEIVED

If well telescopes please sketch and show depths.

GROUND LEVEL

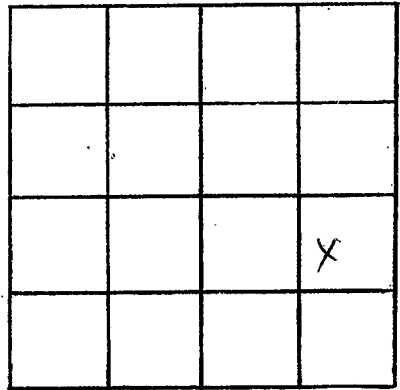

SECTION 14

Please indicate well location X.

ADDITIONAL INFORMATION

If more than one screen, show locations of each on sketch.