

MISSISSIPPI DEPARTMENT OF NATURAL RESOURCES

Bureau of Land and Water Resources

COUNTY WELL LOCATED <i>Wilkinson</i>	
WELL NUMBER <i>5</i>	CODED
DATE WELL COMPLETED <i>2010</i> <i>10-8-86</i>	

PERMIT NUMBER <i>0287</i>
NAME OF DRILLING FIRM <i>Alma Well Service</i>

P.O. Box 10631
Jackson, Mississippi 39209
WATER WELL DRILLERS LOG

NAME & MAILING ADDRESS OF LANDOWNER <i>Johnie Walker</i> <i>Woodville Miss</i>			
WELL LOCATION: SEC	TOWNSHIP	RANGE	
<i>47</i>	<i>3</i>	<i>2</i>	
DISTANCE	DIRECTION	NEAREST TOWN	
<i>07</i> Miles	<i>N-NW</i> of	<i>Woodville</i>	
OTHER LANDMARK <i>none</i>			
WELL PURPOSE (Home, Irrigation, Municipal, Industrial, Fish Pond, etc.)			

PUMP DATA		
PUMP TYPE (Circle One): <input checked="" type="radio"/> Submersible Turbine Jet Flowing Well, Other (Describe) _____		
POWER TYPE (Circle One): <input checked="" type="radio"/> Electric Tractor, Diesel, Gasoline, Butane, Other (Describe) _____		
Pump Capacity (GPM) <i>20</i>	No. of Stages <i>9</i>	Setting Depth <i>165'</i> FT.
PUMP TEST		
Well yielded <i>20'</i> GPM with a drawdown of <i>18'</i> ft. after <i>1</i> hours of pumping		

WELL DATA		
Well Depth <i>173</i>	Casing Diameter (In.) <i>4"</i>	Casing Length (Ft.) <i>163'</i>
Type of Casing <i>P.V.C</i>	Hole Depth <i>173</i>	Depth to Static Water Level <i>118'</i>
TYPE OF COMPLETION: (Circle One or More): <input checked="" type="checkbox"/> Gravel Packed, <input type="checkbox"/> Underreamed, <input type="checkbox"/> Telescoped, <input checked="" type="checkbox"/> Natural Development <input type="checkbox"/> Open Hole, <input type="checkbox"/> Other (Describe) _____		
Top of Lap Pipe or Reduction in Casing		
FEET IF TELESCOPED OR MORE THAN ONE SCREEN: USE BACK PAGE		

LOG DATA	
TYPE OF LOG RUN (Circle One): No Log Run, Electric, Gamma Ray, Density, Sonic, Neutron, Other (Describe) _____	
Name of Organization Running Log	

SCREEN DATA		
Diameter - Inches <i>4"</i>	Length - Feet <i>10'</i>	Slot Size - Inches <i>.012</i>
Screen Type <i>P.V.C</i>	Depth to Bottom - Feet <i>173'</i>	


GEOLOGIC DATA (Office Use Only)			
Surface Elev.	Geologic Unit	Unit Thickness	Depth to Top
Subs. SWL	Date	Analysis	Aquifer Test
Driller's Remarks			

DESCRIPTION OF FORMATIONS ENCOUNTERED	FROM	TO
<i>brown clay</i>	<i>0</i>	<i>31</i>
<i>white sand</i>	<i>31</i>	<i>55</i>
<i>white + blue clay</i>	<i>55</i>	<i>160</i>
<i>Coarse white sand</i>	<i>160</i>	<i>173</i>

FORMATIONS (Continued)	FROM	TO
<div style="font-size: 2em; font-weight: bold; opacity: 0.5;">RECEIVED</div> <div style="font-size: 1.5em; font-weight: bold; margin-top: 10px;">JUL 1 1987</div>		
Department of Natural Resources Bureau of Land & Water Resources		
IF MORE SPACE IS NEEDED, USE BACK		

If well telescopes please sketch and show depths.

GROUND LEVEL

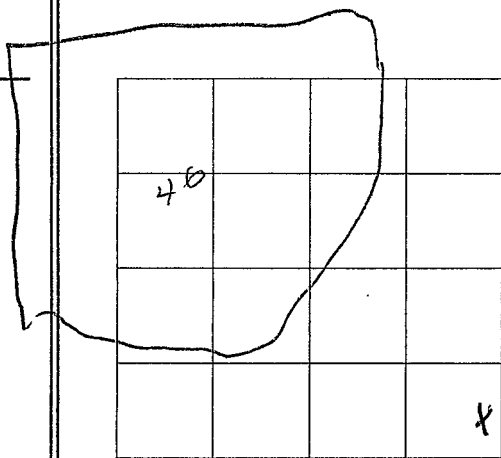

SECTION 47

Please indicate well location X.

ADDITIONAL INFORMATION

If more than one screen,
show location of each on sketch.