

MISSISSIPPI DEPARTMENT OF ENVIRONMENTAL QUALITY

Office of Land and Water Resources

P. O. Box 10631
Jackson, MS 39289-0631
WATER WELL DRILLERS LOG

COUNTY WELL LOCATED <u>Wilkinson</u>	
WELL NUMBER <u>GA</u>	CODED
<u>30A</u>	
DATE WELL COMPLETED <u>9-9-94</u>	

PERMIT NUMBER <u>060</u>
NAME OF DRILLING FIRM <u>Rayburn Drilling</u>
<u>Natchez, ms</u>

NAME & MAILING ADDRESS OF LANDOWNER <u>W. E. Canning</u>			
<u>1433 Lakewood Dr</u>			
<u>Zachary La</u>			
WELL LOCATION:	SEC	TOWNSHIP	RANGE
	<u>50</u>	<u>3</u> ^N _S	<u>2</u> ^E _W
DISTANCE	DIRECTION	NEAREST TOWN	
<u>6</u> Miles	<u>NE</u>	of <u>Woodville</u>	
OTHER LANDMARK			
WELL PURPOSE: Home, Irrigation, Municipal, Industrial, Fish Pond, etc. <u>hunting club</u>			

PUMP DATA		
PUMP TYPE (Circle One): <input checked="" type="radio"/> Submersible Turbine, Jet Flowing Well, Other (Describe) _____		
POWER TYPE (Circle One): <input checked="" type="radio"/> Electric Tractor, Diesel, Gasoline, Butane, Other (Describe) _____ H/P _____		
Pump Capacity (GPM)	No. of Stages	Setting Depth FT.
PUMP TEST		
Well yielded _____ GPM with a drawdown of _____ ft. after _____ hours of pumping		

Well Depth <u>220'</u>	Casing Diameter (In.) <u>4"</u>	Casing Length (Ft.) <u>205</u>
Type of Casing <u>PVC</u>	Hole-Depth <u>220'</u>	Depth to Static Water Level <u>165'</u>

TYPE OF COMPLETION: (Circle One or More):
 Gravel Packed Underreamed, Telescoped,
 Natural Development Open Hole, Other
 (Describe) _____

WELL GROUTED TO A DEPTH OF _____ FEET
 Type Grout (circle one): Cement, Bentonite, or Mix

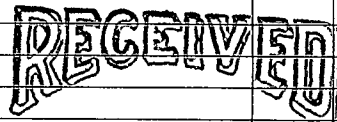
SCREEN DATA		
Diameter - Inches <u>4"</u>	Length - Feet <u>15</u>	Slot Size - Inches <u>.010</u>
Screen Type <u>Sch 40 PVC</u>	Depth to Bottom - Feet <u>220'</u>	

LOG DATA	
TYPE OF LOG RUN (Circle One): <input type="checkbox"/> No Log Run, <input type="checkbox"/> Electric, <input type="checkbox"/> Gamma Ray, <input type="checkbox"/> Density, <input type="checkbox"/> Sonic, <input type="checkbox"/> Neutron, Other (Describe) _____	
Name of Organization Running Log	

GEOLOGIC DATA (Office Use Only)			
Surface Elev.	Geologic Unit	Unit Thickness	Depth to Top
Subs. SWL	Date	Analysis	Aquifer Test

Driller's Remarks		
Top of Lap Pipe or Reduction in Casing		
<table border="1"> <tr> <td>FEET</td> <td>IF TELESCOPED OR MORE THAN ONE SCREEN: USE BACK PAGE</td> </tr> </table>	FEET	IF TELESCOPED OR MORE THAN ONE SCREEN: USE BACK PAGE
FEET	IF TELESCOPED OR MORE THAN ONE SCREEN: USE BACK PAGE	

DESCRIPTION OF FORMATIONS ENCOUNTERED	FROM	TO
<u>TOP SO. 1</u>	<u>0</u>	<u>2</u>
<u>CHALK</u>	<u>2</u>	<u>27</u>
<u>ROCK</u>	<u>27</u>	<u>37</u>
<u>CHALK</u>	<u>37</u>	<u>168</u>
<u>RATTY SAND</u>	<u>168</u>	<u>205</u>
<u>SAND</u>	<u>205</u>	<u>220</u>

FORMATIONS (Continued)	FROM	TO
 SEP 15 1994		
Dept. of Environmental Quality Office of Land & Water Resources		
IF MORE SPACE IS NEEDED, USE BACK		

