

**MISSISSIPPI DEPARTMENT OF ENVIRONMENTAL QUALITY**  
Office of Land and Water Resources

P. O. Box 10631  
Jackson, MS 39289-0631  
**WATER WELL DRILLERS LOG**

COUNTY WELL LOCATED  
Wilkinson

WELL NUMBER G-2026 CODED

DATE WELL COMPLETED  
7-24-01

PERMIT NUMBER  
0-60

NAME OF DRILLING FIRM  
Rayborn Drilling

NAME & MAILING ADDRESS OF LANDOWNER  
Ford Hunting Club  
Box 972  
Woodville, MS 39669

WELL LOCATION: SEC 42 TOWNSHIP 3 RANGE 2  
S E

DISTANCE 3 Miles DIRECTION W NEAREST TOWN Nettles Truck Stop

OTHER LANDMARK

WELL PURPOSE Home Irrigation, Municipal, Industrial, Fish Pond, etc.

**PUMP DATA**

PUMP TYPE (Circle One):  
Submersible, Turbine, Jet, Flowing Well,  
Other (Describe)

POWER TYPE (Circle One):  
Electric, Tractor, Diesel, Gasoline, Butane,  
Other (Describe) H/P 1 1/2

Pump Capacity (GPM) 20 No. of Stages Setting Depth 155 FT.

PUMP TEST  
Well yielded \_\_\_\_\_ GPM with  
a drawdown of \_\_\_\_\_ ft.  
after \_\_\_\_\_ hours of pumping

**WELL DATA**

Well Depth <u>170</u>	Casing Diameter (In.) <u>4</u>	Casing Length (Ft.) <u>155</u>
Type of Casing <u>PVC</u>	Hole Depth <u>170</u>	Depth to Static Water Level <u>80</u>

TYPE OF COMPLETION: (Circle One or More):  
Gravel Packed, Underreamed, Telescoped,  
Natural Development, Open Hole, Other  
(Describe)

**LOG DATA**

TYPE OF LOG RUN (Circle One): No Log Run, Electric, Gamma Ray, Density, Sonic, Neutron, Other (Describe)

Name of Organization Running Log

WELL GROUTED TO A DEPTH OF 10 FEET  
Type Grout (circle one): Cement, Bentonite, or Mix

**GEOLOGIC DATA (Office Use Only)**

Surface Elev.	Geologic Unit	Unit Thickness	Depth to Top
Subs. SWL	Date	Analysis	Aquifer Test

**SCREEN DATA**

Diameter - Inches <u>4</u>	Length - Feet <u>15</u>	Slot Size - Inches <u>.010</u>
Screen Type <u>PVC</u>	Depth to Bottom - Feet <u>170</u>	

Driller's Remarks

Top of Lap Pipe or Reduction in Casing

**FEET** IF TELESCOPED OR MORE THAN ONE SCREEN: USE BACK PAGE


DESCRIPTION OF FORMATIONS ENCOUNTERED	FROM	TO
<u>Topsoil</u>	<u>0</u>	<u>2</u>
<u>Chalk</u>	<u>2</u>	<u>60</u>
<u>Sand w/ shell breaks</u>	<u>60</u>	<u>84</u>
<u>Chalk</u>	<u>84</u>	<u>155</u>
<u>Sand</u>	<u>155</u>	<u>170</u>

FORMATIONS (Continued)	FROM	TO

**REC'D JUL 26 2001**

If well telescopes please  
sketch and show depths.

GROUND LEVEL

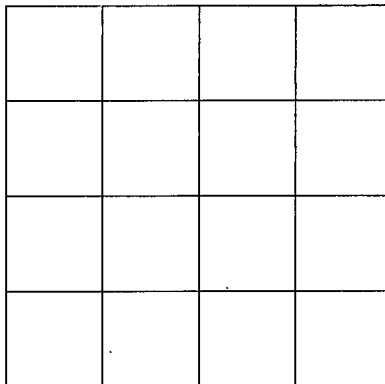

SECTION \_\_\_\_\_

Please indicate well location X.

ADDITIONAL INFORMATION

If more than one screen,  
show location of each on sketch.