

Wilkinson  
H3  
4-67

CODED

MISSISSIPPI  
BOARD OF WATER COMMISSIONERS  
416 North State Street  
Jackson, Mississippi 39201

WATER WELL DRILLERS LOG

April 4 1967 REEVES WELL & PUMPS WILKINSON  
date well completed firm name county well located

LANDOWNER: JAMES PERRY  
RFD 1  
Crosby (mailing address)

description of formations encountered	from	to
Red clay	0	1.5
Yellow sand	1.5	6.5
Red gravel sand	6.5	7.4

WELL LOCATION:  
sec. 8 T. 3 N R. 1 E  
1 miles N of WILKINSON  
(distance) (direction) (nearest town)


WELL PURPOSE: home  
(home, irrigation, municipal, industrial)

- WELL COMPLETION DATA:
- (1) diameter (inches) 4
  - (2) total depth (feet) 74
  - (3) static water level (feet) 63 below top of ground.
  - (4) casing Plastic bottom (material) (depth)
  - 4 (size) if telescope see back.
  - (5) screen 6' 68" (length) (depth to top)  
4" Plastic (size) (material)
  - (6) pump 1/2 Sub 12 (HP) (yield gpm)  
Electric (type power)
  - (7) electric log No (yes or no)

CODED


(organization running log)  
(8) how well bottom plugged plug wooden

DRILLERS REMARKS:

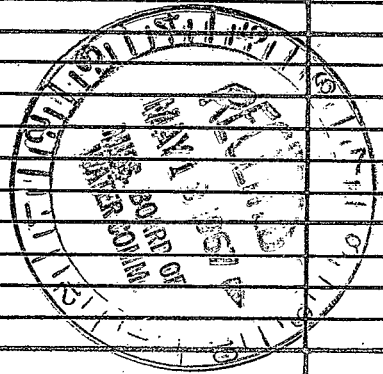

If well telescopes please sketch and show depths.

GROUND LEVEL

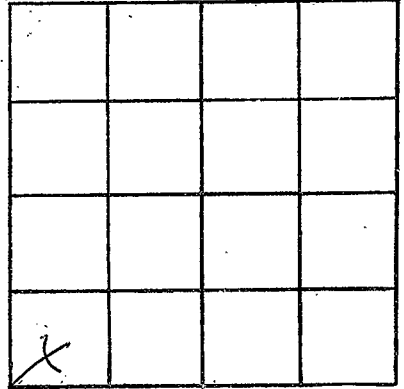

SECTION 8

Please indicate well location X.

ADDITIONAL INFORMATION

If more than one screen, show locations of each on sketch.