

CODED

MISSISSIPPI
BOARD OF WATER COMMISSIONERS
416 North State Street
Jackson, Mississippi 39201

Wilkinson
H4
7-67

WATER WELL DRILLERS LOG

July 15 1967 Felver Well Drilling Co. Wilkinson
date well completed firm name county well located

LANDOWNER: Fred Nettomill Sawmill
Woodville, Miss.
(mailing address)

description of formations encountered	from	to
<u>clay</u>	<u>0</u>	<u>10</u>
<u>white chalk</u>	<u>10</u>	<u>95</u>
<u>coarse grained sand</u>	<u>95</u>	<u>171</u>

WELL LOCATION:
sec. 18 T. 3 N. R. 1 E.
10 miles N-NE of Woodville
(distance) (direction) (nearest town)

WELL PURPOSE: Sawmill
(home, irrigation, municipal, industrial)

WELL COMPLETION DATA:

- (1) diameter (inches) 4"
- (2) total depth (feet) 171
- (3) static water level (feet) 50 below top of ground.
- (4) casing Plastic Bottom
(material) (depth)
- (size) If telescope see back.
- (5) screen 171' 104'
(length) (depth to top)
- 4' Plastic
(size) (material)
- (6) pump 1/2 hp 25
(HP) (yield gpm)
- elect
(type power)
- (7) electric log NO
(yes or no)
- (organization running log)
- (8) how well bottom plugged wooden plug


CODED



DRILLERS REMARKS:

If well telescopes please sketch and show depths.

GROUND LEVEL

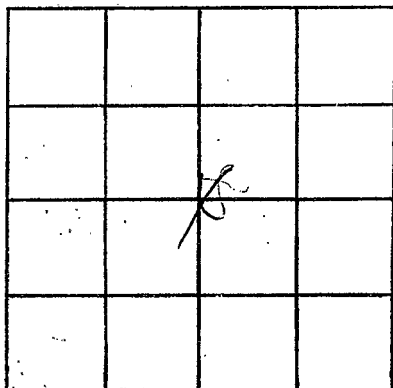

SECTION 107

Please indicate well location X.

ADDITIONAL INFORMATION

If more than one screen, show locations of each on sketch.