

CODED

MISSISSIPPI  
BOARD OF WATER COMMISSIONERS  
416 North State Street  
Jackson, Mississippi 39201

Wilkinson  
H5  
11-68

WATER WELL DRILLERS LOG

Nov. 8 1968 Reynolds & Rump Co Wilkinson  
date well completed firm name county well located

LANDOWNER: Eugene  
Pritchard  
Rt-1, Box 145 - Woodville  
(mailing address)

description of formations encountered	from	to
clay	0	10
sand & gravel	10	18
white chalk	18	205
fine white sand	205	240
coarse sand	240	253

WELL LOCATION:  
sec. 6 T. 3 N. R. 1 E  
1 1/2 miles N Wilkinson  
(distance) (direction) (nearest town)

WELL PURPOSE: Home  
(home, irrigation, municipal, industrial)

WELL COMPLETION DATA:

- (1) diameter (inches) 4"
- (2) total depth (feet) 253
- (3) static water level (feet) 90 below above top of ground.
- (4) casing Plastic Bottom  
(material) (depth)  
\_\_\_\_\_ if telescope see back.  
(size)
- (5) screen 6' 247'  
(length) (depth to top)  
4 Plastic  
(size) (material)
- (6) pump 3/4 sub-15  
(HP) (yield gpm)  
elect-  
(type power)
- (7) electric log No.  
(yes or no)

\_\_\_\_\_ (organization running log)

(8) how well bottom plugged wooden plug


DRILLERS REMARKS:  
New house location

CODED



If well telescopes please sketch and show depths.

GROUND LEVEL

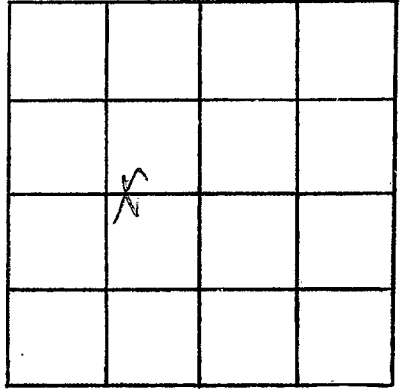

SECTION 6

Please indicate well location X.

ADDITIONAL INFORMATION

If more than one screen,  
show locations of each on sketch.