

CODED

Wilkinson  
HT  
10-11-68

MISSISSIPPI  
BOARD OF WATER COMMISSIONERS  
416 North State Street  
Jackson, Mississippi 39201

WATER WELL DRILLERS LOG

Oct 11 68 Beenswell Drilling Wilkinson  
date well completed firm name county well located

LANDOWNER: Fred Nettleton - Fred Woodruff  
(mailing address)

description of formations encountered	from	to
yellow chalk	0	14
Sand & gravel	14	28
blue chalk	28	46
Coarse sand	46	107

WELL LOCATION:  
sec. 19 T. 3 N. R. 1 W.  
at Wilkinson miles of (distance) (direction) (nearest town)

WELL PURPOSE: same  
(home, irrigation, municipal, industrial)

WELL COMPLETION DATA:

- (1) diameter (inches) 4"
- (2) total depth (feet) 107
- (3) static water level (feet) 70 below top of ground
- (4) casing Plastic Ballast  
(material) (depth)

(size) if telescope see back.

- (5) screen 6' 10'  
(length) (depth to top)
- 4" Plastic  
(size) (material)
- (6) pump 1/2 HP Sub 15  
well (yield gpm)
- 3/4 HP  
(type power)

(7) electric log yes or no

(organization running log)

(8) how well bottom plugged wooden plug


DRILLERS REMARKS: new bore

DEC 16 1968

MISS. BD. OF  
WATER COMM.

If well telescopes please sketch and show depths.

GROUND LEVEL

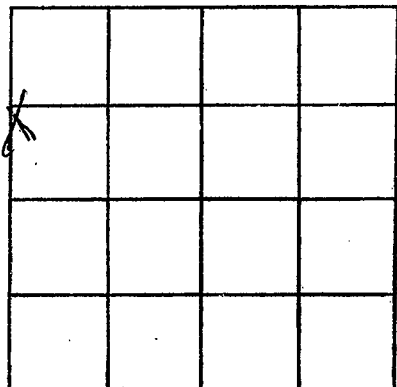

SECTION 19

Please indicate well location X.

ADDITIONAL INFORMATION

If more than one screen, show locations of each on sketch.