

Wilkinson
H 8
12-68

MISSISSIPPI
BOARD OF WATER COMMISSIONERS
416 North State Street
Jackson, Mississippi 39201

WATER WELL DRILLERS LOG

INDEX

Dec 20 1968 Reeves Well Drilling Co. Wilkinson
date well completed firm name county well located

LANDOWNER: Tom Ashley
Rt-1, Crasby
(mailing address)

| description of formations encountered | from | to |
|---------------------------------------|------|-----|
| yellow clay | 0 | 17 |
| sand & gravel | 17 | 36 |
| hard gray shale | 36 | 92 |
| coarse sand | 92 | 121 |

WELL LOCATION:
sec. 11 T. 3 N R. 1 E
4 miles east of Wilkinson
(distance) (direction) (nearest town)

WELL PURPOSE: Home
(home, irrigation, municipal, industrial)

WELL COMPLETION DATA:
(1) diameter (inches) 4"
(2) total depth (feet) 121
(3) static water level (feet) 77 below top of ground.
(4) casing Plastic bottom
(material) (depth)

(size) If telescope see back
(5) screen 6' 115
(length) (depth to top)
4" Plastic
(size) (material)
(6) pump 1/2 sub 12
(HP) (yield gpm)
elect
(type power)

(7) electric log
(yes or no)
(organization running log)

(8) how well bottom plugged
wooden plug

DRILLERS REMARKS:
old well bad


INDEX

MAR 1969

MISS. BO. OF WATER WORKS

If well telescopes please sketch and show depths.

GROUND LEVEL

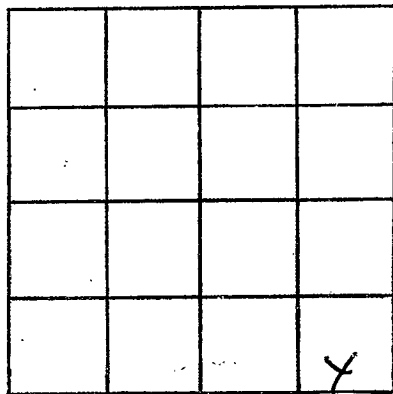

SECTION 11

Please indicate well location X.

ADDITIONAL INFORMATION

If more than one screen,
show locations of each on sketch.