

**WILKINSON**  
**H10**  
**12-17-71**

MISSISSIPPI  
 BOARD OF WATER COMMISSIONERS  
 416 North State Street  
 Jackson, Mississippi 39201

**CODED**

**WATER WELL DRILLERS LOG**

Dec 17 1971 Chestertown Williamson  
 date well completed firm name county well located

LANDOWNER: *William Woodville*  
 Woodville  
 (mailing address)

description of formations encountered	from	to
Clay	0	10
white sand	10	27
white & blue chert	27	120
fine blue sand	120	135
Coarse sand	135	150

WELL LOCATION:  
 sec. 17 T-3 N2 R-1 W  
 of Wilkinson  
 (distance) (direction) (nearest town)

WELL PURPOSE: *Sanmill*  
 (home, irrigation, municipal, industrial)


- WELL COMPLETION DATA:
- (1) diameter (inches) 4"
  - (2) total depth (feet) 150
  - (3) static water level (feet) \_\_\_\_\_ below/above top of ground.
  - (4) casing Plast Bottom  
 (material) (depth)
  - \_\_\_\_\_ if telescope see back.  
 (size)
  - (5) screen 1" 139  
 (length) (depth to top)  
4" Plast  
 (size) (material)
  - (6) pump 1 1/2 HP by  
 (HP) (yield gpm)  
Crowder  
 (type power)
  - (7) electric log no  
 (yes or no)
  - \_\_\_\_\_ (organization running log)
  - (8) how well bottom plugged water plug

**CODED**

DRILLERS REMARKS:  
*Community system water not dependable.*

If well telescopes please sketch and show depths.

GROUND LEVEL

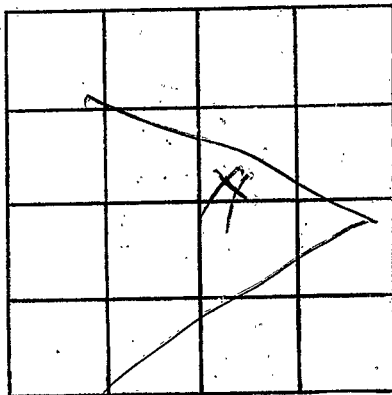

SECTION 17

Please indicate well location X.

ADDITIONAL INFORMATION

If more than one screen, show locations of each on sketch.