

Wilkinson
 H 11
 5/29/79

MISSISSIPPI
 BOARD OF WATER COMMISSIONERS
 416 North State Street
 Jackson, Mississippi 39201

CODED

WATER WELL DRILLERS LOG

5-29-79 date well completed
 Rayborn Drill & Const. Co. firm name
 Wilkinson county well located

LANDOWNER:

Netterville Lumber Co.
 Woodville, MS.
 (mailing address)

description of formations encountered

description of formations encountered	from	to
Top soil	0	2
bluish clay	2	110
Coarse sand	110	146

WELL LOCATION:

sec. 7 T. 3 N. R. 1 E.
 S W
 1/4 miles N of Wilkinson
 (distance) (direction) (nearest town)

WELL PURPOSE:

industrial
 (home, irrigation, municipal, industrial)

CODED

WELL COMPLETION DATA:

- diameter (inches) 4"
- total depth (feet) 146'
- static water level (feet) 40' below above top of ground.
- casing Galv. 126'
(material) (depth)
4" (size) if telescope see back.
- screen 20' 126'
(length) (depth to top)
4" SS
(size) (material)
- pump 7 1/2 100 gpm
(HP) (yield gpm)
elec
(type power)
- electric log no
(yes or no)
(organization running log)
- how well bottom plugged wood plug

DRILLERS REMARKS:


DEPT. OF NATURAL RESOURCES
 BUREAU OF LAND & WATER RESOURCES

DEC 20 1979

RECEIVED

If well telescopes please sketch and show depths.

GROUND LEVEL

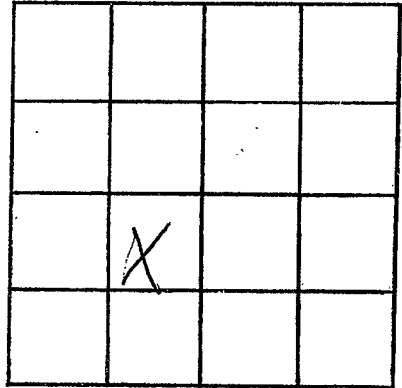

SECTION 7

Please indicate well location X.

ADDITIONAL INFORMATION

If more than one screen,
show locations of each on sketch.