

MISSISSIPPI DEPARTMENT OF NATURAL RESOURCES

Bureau of Land and Water Resources

Southport Mall

P.O. Box 10631

Jackson, Mississippi 39209

WATER WELL DRILLERS LOG

CODED

Wilkinson
H20
9-21-81

9-21-1981 date well completed Rayborn Drilling & Const Co. firm name Wilkinson county well located

LANDOWNER:

Manchester Drilling, Inc.
Udalia, La
(mailing address)

description of formations encountered

from to

Top soil 0 2
Sandstone 2 30
Sandstone 30 115

WELL LOCATION:

sec. 16 T. 30 N. R. 1 E
2 miles W of Buffalo.
(distance) (direction) (nearest town)

WELL PURPOSE:

(home, irrigation, municipal, industrial)

WELL COMPLETION DATA:

- (1) diameter (inches) 3"
- (2) total depth (feet) 115'
- (3) static water level (feet) 30' below top of ground.
- (4) casing PVC, 95' (material) (depth)
3" (size) if telescope see back.
- (5) screen 20' (length), 95' (depth to top)
3" (size), slotted pipe (material)
- (6) pump 40 GPM (HP) (yield gpm)
- (7) electric log no (yes or no)

(organization running log)

- (8) how well bottom plugged wood plug

DRILLERS REMARKS:


DEPT. OF NATURAL RESOURCES
BUREAU OF LAND & WATER RESOURCES

SEP 26 1981

RECEIVED

If well telescopes please sketch and show depths.

GROUND LEVEL

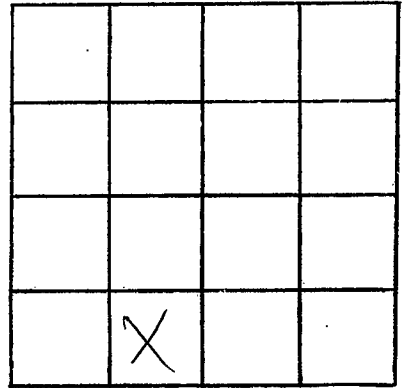

SECTION 16

Please indicate well location X.

ADDITIONAL INFORMATION

If more than one screen,
show locations of each on sketch.