

WILKINSON

H 21

11-19-81

MISSISSIPPI DEPARTMENT OF NATURAL RESOURCES

Bureau of Land and Water Resources

Southport Mall

P.O. Box 10631

Jackson, Mississippi 39209

WATER WELL DRILLERS LOG

CODED

11-19 1981 Rayburn Drill. & Const. Co. Wilkinson  
date well completed firm name county well located

LANDOWNER:

Rebel Drill. Co.

Natchez, MS.  
(mailing address)

WELL LOCATION:

sec. 32 T. 3 N. R. 1 E  
1.2 miles NW of Centerville  
(distance) (direction) (nearest town)

WELL PURPOSE:

(home, irrigation, municipal, industrial)

WELL COMPLETION DATA:

- (1) diameter (inches) 3"
- (2) total depth (feet) 150'
- (3) static water level (feet) 40' below top of ground.
- (4) casing (material) (depth) 130' 2" (size) if telescope see back.
- (5) screen (length) (depth to top) 20' 130' 2" (size) (material) Slotted Pipe
- (6) pump (HP) (yield gpm) 42 GPM  
(type power) elec.
- (7) electric log (yes or no) NO  
(organization running log)

(8) how well bottom plugged wood plug

DRILLERS REMARKS:

description of formations encountered

Top soil 0 21  
Shale 2 90  
sand 70 150

fr SE/Cor Sec. 31 go W 1/4  
alg Sec. 1L 3154' th N 1/4  
RA 2309' to loc in Sec. 32

CODED


DEPT. OF NATURAL RESOURCES  
BUREAU OF LAND & WATER RESOURCES

DEC-3 1981

RECEIVED

If well telescopes please  
sketch and show depths.

GROUND LEVEL

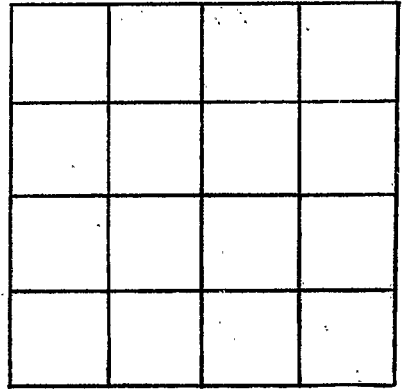

SECTION \_\_\_\_\_

Please indicate well location X.

ADDITIONAL INFORMATION

If more than one screen,  
show locations of each on sketch.