

MISSISSIPPI DEPARTMENT OF NATURAL RESOURCES

Bureau of Land and Water Resources

Southport Mall

P.O. Box 10631

Jackson, Mississippi 39209

**CODED**

WATER WELL DRILLERS LOG

WILKINSON  
H 22  
2-20-82

2-30 1982

82 Reynolds Drilling Wilkison  
firm name county well located

LANDOWNER:

Rebel Drilling

Natches MS

(mailing address)

WELL LOCATION:

sec. 14 T. 3 N. R. 1 E. S. W

1 miles NE of Southern

(distance) (direction) (nearest town)

WELL PURPOSE:

(home, irrigation, municipal, industrial)

description of formations encountered

from to

<u>top soil</u>	<u>0</u>	<u>10</u>
<u>gravel</u>	<u>10</u>	<u>40</u>
<u>clay</u>	<u>40</u>	<u>100</u>
<u>sand</u>	<u>100</u>	<u>160</u>
<u>gumbo</u>	<u>160</u>	<u>360</u>
<u>sand</u>	<u>360</u>	<u>475</u>

WELL COMPLETION DATA:

- (1) diameter (inches) 3"
- (2) total depth (feet) 475'
- (3) static water level (feet) 150 <sup>below</sup>/<sub>above</sub> top of ground.
- (4) casing hbk 455'  
(material) (depth)  
3"  
(size) if telescope see back.
- (5) screen 20' 455'  
(length) (depth to top)  
3" slotted pipe  
(size) (material)
- (6) pump - 50  
(HP) (yield gpm)  
elec  
(type power)
- (7) electric log -  
(yes or no)

**CODED**

**CODED**

(organization running log)

(8) how well bottom plugged wood

DRILLERS REMARKS:


DEPT. OF NATURAL RESOURCES  
BUREAU OF LAND & WATER RESOURCES

MAR - 8 1982

**RECEIVED**

If well telescopes please  
sketch and show depths.

GROUND LEVEL

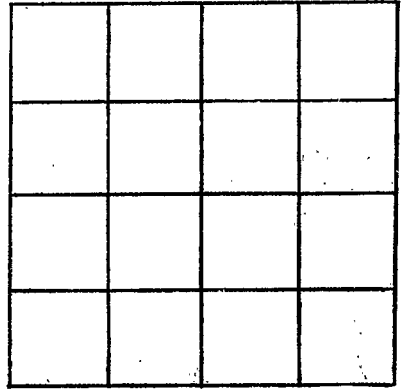

SECTION \_\_\_\_\_

Please indicate well location X.

ADDITIONAL INFORMATION

If more than one screen,  
show locations of each on sketch.