

MISSISSIPPI DEPARTMENT OF NATURAL RESOURCES

Bureau of Land and Water Resources

Southport Mall

P.O. Box 10631

Jackson, Mississippi 39209

WATER WELL DRILLERS LOG

TOM GRIFFITH

PLUMBING & WELL SERVICE, INC.

CODED

Wilkinson

H23  
Wilkinson  
12-2-84

12-2-84  
date well completed


320 MAYSON AVE.  
COLUMBIA, MS 39429

county well located

LANDOWNER:	description of formations encountered	from	to
Texaco			
Texaco Building	Gravel	0	115
New Orleans, La. (mailing address)	Chalk	115	215
	Sand (Good)	215	255
	Hard Chalk & Streaked Sand	255	540
	Sand (Good)	540	620
WELL LOCATION: sec. 25 T 30 S R 1 E 5 miles W of Gloster (distance) (direction) (nearest town)	No. 1 Longleaf Enterprises 504'S + 1599'E of NW/CR		
WELL PURPOSE: OIL LOG (home, irrigation, municipal, industrial)			
WELL COMPLETION DATA:			
(1) diameter (inches) 4"			
(2) total depth (feet) 620'			
(3) static water level (feet) 180' below top of ground.			
(4) casing T&C 580' (material) (depth)			
n/a If telescope see back. (size)			
(5) screen 40' 580' (length) (depth to top)			
4" slot (size) (material)			
(6) pump A112 70 (HP) (yield gpm)			
Diesel (type power)			
(7) electric log NO (yes or no)			
n/a (organization running log)			
(8) how well bottom plugged welded			
DRILLERS REMARKS:			
2- identical water wells on this location			

If well telescopes please sketch and show depths.

GROUND LEVEL

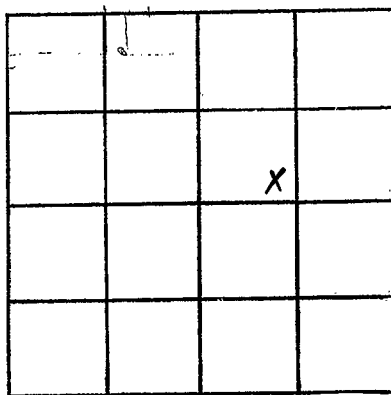

SECTION 25

Please indicate well location X.

ADDITIONAL INFORMATION

If more than one screen,  
show locations of each on sketch.