

MISSISSIPPI DEPARTMENT OF ENVIRONMENTAL  
QUALITY

Office of Land and Water Resources

P. O. Box 10631

Jackson, MS 39289-0631

WATER WELL DRILLERS LOG

COUNTY WELL LOCATED Witterson	
WELL NUMBER #2	CODED
A-30	
DATE WELL COMPLETED 1-15-04	

PERMIT NUMBER 10-60
NAME OF DRILLING FIRM Rayborn Drilling
Natchez MS 39120

NAME & MAILING ADDRESS OF LANDOWNER

Netherville Lumber Company  
P.O. BOX 857  
Woodville, MS 39069

Latitude:  
Longitude:

WELL LOCATION. SEC 18 TOWNSHIP 3 N RANGE 1 W

DISTANCE 7 Miles DIRECTION N of NEAREST TOWN Woodville

OTHER LANDMARK

WELL PURPOSE: Home, Irrigation, Municipal, Industrial, Fish Pond, etc.

WELL DATA

Well Depth 130	Casing Diameter (In.) 4	Casing Length (Ft.) 110
-------------------	----------------------------	----------------------------

Type of Casing PVC	Hole Depth 130	Depth to Static Water Level 42
-----------------------	-------------------	-----------------------------------

TYPE OF COMPLETION: (Circle One or More):  
 Gravel Packed,  Underreamed,  Telescoped,  
 Natural Development,  Open Hole,  Other  
 (Describe)

WELL GROUTED TO A DEPTH OF 50 FEET  
 Type Grout (circle one):  Cement,  Bentonite, or Mix

SCREEN DATA

Diameter - Inches 4	Length - Feet 20	Slot Size - Inches .010
------------------------	---------------------	----------------------------

Screen Type PVC	Depth to Bottom - Feet 132
--------------------	-------------------------------

PUMP DATA

PUMP TYPE (Circle One):  
 Submersible,  Turbine,  Jet,  Flowing Well,  
 Other (Describe)

POWER TYPE (Circle One):  
 Electric,  Tractor,  Diesel,  Gasoline,  Butane,  
 Other (Describe) H/P

DESCRIPTION OF FORMATIONS ENCOUNTERED	FROM	TO
Chalk	0	30
Chalk + gravel mix	30	80
sand	80	130

RECEIVED  
FEB 18 2004  
BY: OLWR

Top of Lap Pipe or Reduction in Casing

FEET  IF TELESCOPED OR MORE THAN ONE SCREEN: USE BACK PAGE

I certify that the well was drilled, constructed and completed in accordance with all applicable Requirements of the Mississippi Department of Environmental Quality and/or the Mississippi Department of Health regulations and state laws.


Signature of Licensed Driller and License No. 10-60

Date 1-10-04

Additional Information Required On Back

If well telescopes please sketch and show depths.

GROUND LEVEL

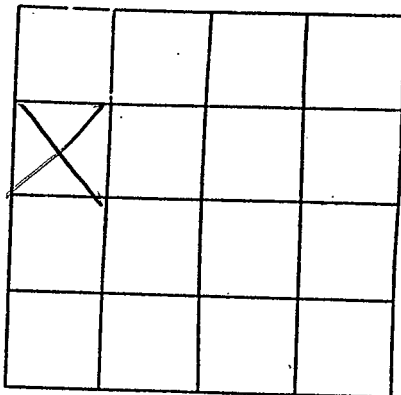

SECTION 18

Please indicate well location X.

Pump Capacity (GPM)	No. of Stages	Setting Depth	
75	15	84	FT.

PUMP TEST

Well yielded \_\_\_\_\_ GPM with  
 a drawdown of \_\_\_\_\_ ft.  
 after \_\_\_\_\_ hours of pumping

LOG DATA

TYPE OF LOG RUN (Circle One): No Log Run,  
 Electric, Gamma Ray, Density, Sonic, Neutron,  
 Other (Describe) \_\_\_\_\_

Name of Organization Running Log \_\_\_\_\_

GEOLOGIC DATA (Office Use Only)

Surface Elev.	Geologic Unit	Unit Thickness	Depth to Top
Subs. SWL	Date	Analysis	Aquifer Test

Driller's Remarks

If more than one screen,  
 show location of each on sketch.