County: Wilkinson	H	Vell Report	For Office Use Only:	
Driller: Gary Rayborn	Office of Land P.O. Jackson, N	nt of Environmental Quality and Water Resources Box 10631 MS 39289-0631 0061 5210	Aquifer:	
Date drilling completed: 5307)961-5210 54-6938 (fax)	E-log #:	
State Law requires that this repo	ort be prepared by the			
30 days of completion of drilling Well Owner Informa	tion		ll Location	
Dwner Name Energy Drilling		Latitude:°'	_" Longitude:°'"	
Mailing Address: P.O. Box 905		Method of Lat/Long (circle one): Conventional Survey,		
			d GPS, Survey-grade GPS	
Nothez NS	39121	1/41/4 Sec	Twn <u>3N</u> Rng IW	
Natchez M ⁵ City Str Telephone No. (601) 446-5	ate Zip Code	Distance Direction	of Crosby Woodull	
Telephone No. (<u>1001)</u>		ll Data	~	
Purpose of Well (circle one) Home In Date well drilling started: $53/6$ If flowing, method of flow regulation: Vi Static Water Level: 80 feet a Method of Measurement (circle one) Hole depth: 160 Well d Type of grout (circle one): Cement Casing length: 140 feet Ca Screen length: 20 feet Sc Screen slot size: 1020 inches Type of completion (circle all applicable	Data Data te well drilling completed: (describe) e) land surface Date measured npe air line other: Well grouted to a depth of lix inches Type of casing inches Type of screen mf_0feet to	$f = \frac{10}{100}$ $f = \frac{10}{100}$ $f = \frac{10}{100}$ $f = \frac{100}{100}$ $f = \frac{100}{100}$ $f = 100$	
Top of lap pipe or reduction in casing: _				
Logs run (circle all applicable) No log	run Electric Gamma	Ray Density Sonic Neutron	0 Other:	
Name of organization running log(s): I certify that the well was drilled, con Department of Environmental Qualit	structed, and completed	in accordance with an applica	ble requirements of the Mississipp ions and state laws.	
RAYBORN DRILLING, INC.	2 1	0		
Print Name of Water Well Contractor a		Signad	re of Water Well Contractor	
			RECEIVE	
			MAY 2 4 2007	

•


e .,

If well telescopes please sketch below and show depths.



r	Description of Formations Encountered	From	To
	Clay	0	50
	Sand	50	९०
	clay	80	130
	Sand	130	160
•			
			1

If more than one screen, show location of each on sketch

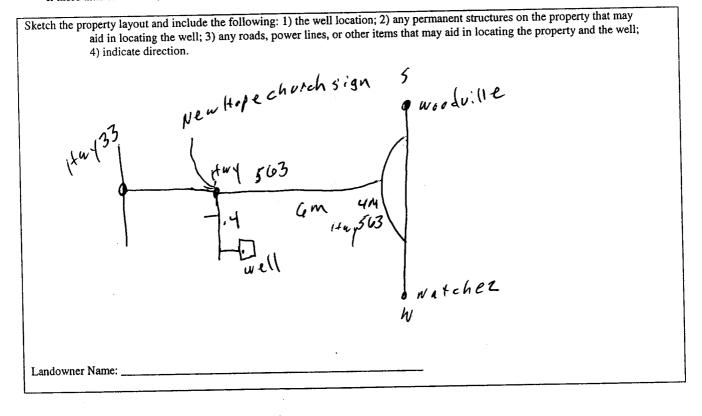

Signature of Water Well Contractor

MAY 2 4 2007 BY: OLWR

H- 36

	STATE WELL REPORT Part 2		For Office Use Only:	
County: Wilkinson		Pump Installer's Completion Report Mississippi Department of Environmental Quality		
Permit #: Driller: Gary Rayborr	Mississippi Department	nd Water Resources	Aquifer: Well #: <u>H-36</u>	
ermit #:	P.O. B	P.O. Box 10631		
Driller: Gary Kayborr	Jackson, M	Jackson, MS 39289-0631		
Date completed 5 307	(601)	961-5210 4-6938 (fax)	Elevation:	
	, ,			
This report should be prepare	d by the pump installer in detai	l and filed with the Departme	nt within 30 days of the	
installation of pump. Well Owner Information		Well Location		
Energy I	Deilling	Latitude:	_ Longitude:	
Dwner Name: <u>Energy</u> I	<u>Ang</u>			
Mailing Address: P. 0.B	0× 905		one): Conventional Survey,	
		-	d-held GPS, Survey-grade GPS	
Notcher	MS 39121	1414 Sec	<u> </u>	
City	<u>MS 39121</u> State Zip Code			
	<i>(- c</i>	Distance Direction	Nearest Town	
Telephone No. (601) 446-	5259	$\underline{15}_{\text{Miles}} \underline{NE}$	of <u>Crosky</u>	
Ритр Туре		Power Type Circle one		
Circle	one			
Air Lift Jet	Submersible	Diesel Engine Gasol	ine Engine Natural Gas	
Bucket Piston	Turbine	Electric Motor Hand	Tractor PTO	
Centrifugal Rotary	Flowing Well		r (specify):	
		Horse Power Rating of Motor:5 HP		
Other (specify): Date Pump Installed:5307		Setting Depth:feet		
4		Number of Stages:14		
Rated Pump Capacity:	()Gallons Per Minute	Number of Stages:	1-1	
	· · · · · · · · · · · · · · · · · · ·		formula a Watan I aval	
Pump To			Ieasuring Water Level Circle one	
Date Well Tested:5307				
Static Water Level (A): Feet Below Land Surface		Air Line Electric M	easuring Line Steel Tape	
		Other (specify):	·	
Pumping Water Level (B):	Feet Below Land Surface			
Drawdown [(B) – (A)]:Feet Below Land Surface		For flowing well, measured shut in head:feet		
Test Pumping Rate: 60 Gallons Per Minute		Well yielded 60	GPM with a drawdown of	
	,		rhours of pumping	
Duration of Pump Test (minimum	4 hours):hours		nous of pumping	
L				
I HEREBY CERTIFY that the ab	ove statements are true to the bes	t of my knowledge.		
	~ / ~	Í.		
Gary Rayborn	License No. (if applicable)	Signature of Pump		

Print Name of Pump Installer and License No. (if applicable)

.

٠

RECEIVED MAY 2 4 2007 BY: OLWR