State Well Report				
	urt 1	For Office Use Only:		
Mississippi Department	of Environmental Quality	Aquifer:		
	Office of Land and Water Resources P.O. Box 10631			
	S 39289-0631	L. S. Elevation:		
Date drining completed. — 10.1.	(601)961-5210 (601)354-6938 (fax)			
State Law requires that this report be prepared by the driller in detail and filed with the Department within				
30 days of completion of drilling of the well.				
Well Owner Information		Location		
Owner Name W. Howard Netternille	Latitude: 31 . 12, 42	-" Longitude: 91 ° 14 '09 "		
Mailing Address:	Method of Lat/Long (circle or	ne): Conventional Survey,		
P.O. BOX 1868		I GPS, Survey-grade GPS		
Woodville US 39669	1R 1/4 1R 1/4 Sec 23	Twn 3N Rng 100		
City State Zip Code	Distance Direction	Nearest Town of Buffalo		
Telephone No. (401) 870-5922	Miles	of DUTTA 10		
Well I	Data			
Purpose of Well (circle one) Home Industrial Public Supply Irrigation Fish Culture Other:				
	well drilling completed:3	18/12		
	·			
If flowing, method of flow regulation: Valve Other (describe) Static Water Level: feet above of below (direct one) land surface Date measured:				
Method of Measurement (circle one) steel tape electric tape air line other:				
Hole depth: 2351 Well depth: 2351 Well grouted to a depth of 10 feet				
Type of grout (circle one): Cement Bentonite Mix				
Casing length: 215 feet Casing diameter: 4 inches Type of casing: PVC				
Screen length: 20 feet Screen diameter: 4 inches Type of screen: PVC				
716 736				
Type of completion (effects an application).				
Other (describe):				
Top of lap pipe or reduction in casing:feet. If telescoped or more than one screen, describe on back of page				
Logs run (circle all applicable): No log run Electric Gamma Ray Density Sonic Neutron Other:				
Name of organization running log(s):				
I certify that the well was drilled, constructed, and completed in accordance with all applicable requirements of the Mississippi				
Department of Environmental Quality and/or the Mississippi Department of Health regulations and state laws.				
RAYBORN DRILLING, INC.				

Print Name of Water Well Contractor and License No.

APR 0 4 2012


Signature of Water West Contractor

If well telescopes please sketch below and show depths.

Ground Level	

Description of Formations Encountered	From	То
	10	30
CHALIA	+ -	30
Pea Gravel	30	60
CHALK	60	175
Fine SAND	175	190
CHALK	190	215
SAND	215	235
		-
		-

If more than one screen, show location of each on sketch

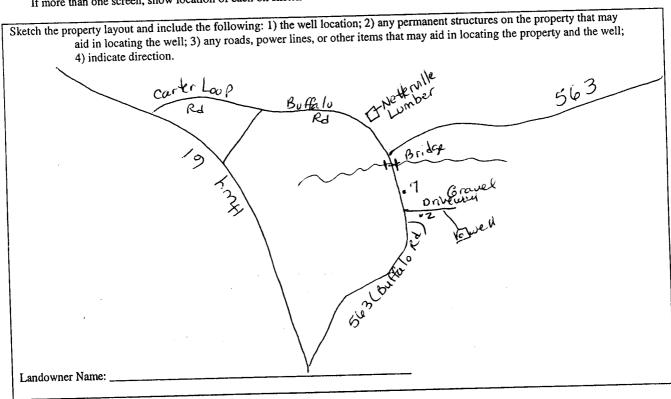



Signature of Water Well Contractor

RECEIVED

APR 0 4 2012

BY: OLWR

STATE WELL REPORT

County: Wilkinson Permit #: ______ Driller: Gan Rayborn

Date completed:

Part 2 Pump Installer's Completion Report

Pump Installer's Completion Report
Mississippi Department of Environmental Quality
Office of Land and Water Resources
P.O. Box 10631
Jackson, MS 39289-0631
(601)961-5210
(601)354-6938 (fax)


For Office Use Only:		
Aquifer:		
Well #:	H42	_
Elevation: _		

This report should be prepared by the pump installer in detail and filed with the Department within 30 days of the

installation of pump.			
Well Owner Information	Well Location		
Owner Name: W, Howard Netterville	Latitude:Longitude:		
Mailing Address: P.O. Box 1868	Method of Lat/Long (circle one): Conventional Survey, USGS quad, Hand-held GPS, Survey-grade GPS		
Wood ville MS 39669 City State Zip Code	Distance Direction Nearest Town		
Telephone No. (601) 870 - 5922			
Pump Type Circle one	Power Type Circle one		
Air Lift Jet Submersible	Diesel Engine Gasoline Engine Natural Gas		
Bucket Piston Turbine	Electric Motor Hand Tractor PTO		
Centrifugal Rotary Flowing Well	Windmill Other (specify):		
Other (specify): Date Pump Installed: Rated Pump Capacity: Gallons Per Minute	Horse Power Rating of Motor: Setting Depth: Number of Stages:		
Pump Test Data Date Well Tested: 3 8 5 Static Water Level (A): Feet Below Land Surface Pumping Water Level (B): Feet Below Land Surface	Method of Measuring Water Level Circle one Air Line Electric Measuring Line Steel Tape Other (specify):		
Drawdown [(B) - (A)]:Feet Below Land Surface	For flowing well, measured shut in head:feet		
Test Pumping Rate: Gallons Per Minute	Well yielded GPM with a drawdown of		
Duration of Pump Test (minimum 4 hours):hours	feet afterhours of pumping		

I HEREBY CERTIFY that the above statements are true to the best of my knowledge.

RAYBORN DRILLING, INC.

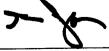

Print Name of Pump Installer and License No. (if applicable)

Signature of Pump Installer

RECEIVE

APR 0 4 2012

BY: OLWR