
| State Wall Deport  | ······   |
|--|--|
| <b>I</b> State Well Report   | For Office Use Only:                           |
| County: Wilkinson Part 1   |  |
| Mississippi Department of Environmentar  | Quality Aquifer:                               |
| Permit #: Office of Land and Water Resources   | Well #: <u>H43</u>                             |
| Driller: 91512 P.O. Box 10631<br>Jackson, MS 39289-0631  |  |
|  | L. S. Elevation:                               |
| Date drilling completed Carpaybor (601)961-5210<br>(601)354-6938 (fax)   |  |
| (601)354-6938 (fax)  | E-log #:                                       |
| State Law requires that this report be prepared by the driller in detail and   | l filed with the Department within             |
| 30 days of completion of drilling of the well.   | Well Location                                  |
| Well Owner Information   |  |
| where Name W, Ward of the  | ,43" Longitude: <u>91 • 14</u> , 02."          |
| Tailing Address:   | (circle one): Conventional Survey,             |
| USGS quad, H   | land-held GPS, Survey-grade GPS                |
| Woodville, MS 39669<br>City State Zip Code Diverse Diver | Sec_ $33$ Twn $3N$ Rng $W$                     |
|  | irection Nearest Town                          |
| Felephone No. (601) 870-5922   | a3<br>irection Negrest Town<br>of <u>Du Ha</u> |
| Well Data  |  |
| Purpose of Well (circle one) Home Industrial Public Supply Irrigation Fish   | Culture Other:                                 |
| Purpose of Well (circle one) Home Industrial Public Supply Irrigation Fish   | alieliz  |
| Date well drilling started:  | d:   |
| If flowing, method of flow regulation: Valve Other (describe)  | QUELD  |
| Static Water Level:feet above or below (circle one) land surface Date 1  | measured: 115/12                               |
| Method of Measurement (circle one) steel tape electric tape air line of  | ther:  |
| Hole depth: Well depth: Well grouted to a  | depth offeet                                   |
| Type of grout (circle one): Cement Bentonite Mix   |  |
|  | $\rho_{\text{traing:}} \rho_{\text{VC}}$       |
| Casing length: <u>50</u> feet Casing diameter: <u>4</u> inches Type C  |  |
|  | of screen: PVC                                 |
| <b>F</b> O   | 1000000000000000000000000000000000000          |
|  |  |
| Type of completion (circle all applicable): Gravel packed Underreamed Telescop   | ed Open hole Natural Development               |
|  |  |
| Other (describe):  |  |
| Top of lap pipe or reduction in casing:feet. If telescoped or more t   | han one screen, describe on back of page       |
| Top of lap pipe or reduction in casing:iet. If these proves of instruction   |  |
| Logs run (circle all applicable): No log run Blectric Gamma Ray Density Sonic  | Neutron Other:                                 |
| None of according topping log(s)   |  |
| Name of organization running log(s):<br>I certify that the well was drilled, constructed, and completed in accordance with all   | applicable requirements of the Mississippi     |
| I CEI ILLY ILLAL ILE WEIL WAS ULINUU, COMMA DECENTION TO THE TOTAL   | regulations and state laws.                    |
| Department of Environmental Quality and/or the Mississippi Department of Health  | -  |
|  |  |
| RAYBORN DRILLING, INC. 0-60  |  |
|  | Signature of Water Walcontractor               |
| Print Name of Water Well Contractor and License No.  |  |
|  |  |
|  | SER FOR EN                                     |
|  |  |

If well telescopes please sketch below and show depths.

Ground Level

| round Level | Description of Formations Encountered | From | To |
|-------------|---------------------------------------|------|----|
|             | CHALK                                 | 6    | 30 |
|             | SAND + GRAVEL                         | 30   | 70 |
|             |                                       |      |    |
|             |                                       |      |    |
|             |                                       |      | -  |
|             |                                       |      | 1  |
|             |                                       |      |    |
| · · · · ·   |                                       |      |    |
|             |                                       |      |    |

If more than one screen, show location of each on sketch

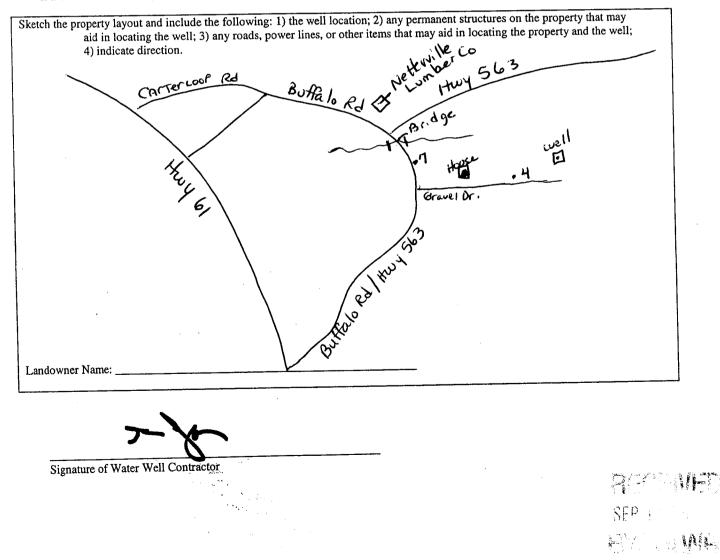

| Driller: GARY RAY BORN                                    |                                 |  |  |             |  |
|---|---------------------------------|--|--|-------------|--|
| Permit #:<br>Driller: GARY RAY BORN                       |                                 | art 2  | For Office Use Only:                       |             |  |
| Driller: GARY RAY BORN                                    | Pump Installer's                | s Completion Report  |  |             |  |
| Driller: GARY RAY BORN                                    | Permit #:                       |  | Aquifer:                                   |             |  |
|   |                                 |  | Well #:                                    |             |  |
| Date completed: <u>9-15-12</u>                            |                                 |  |  |             |  |
| This report should be prepared by t installation of pump. | لہ<br>he pump installer in deta | il and filed with the Departme   | ent within 30 days                         | of the      |  |
| Well Owner Informa  | ition                           | We   | ell Location                               |             |  |
| owner Name: W HOWARD NE                                   | ETTERVILLE                      | Latitude:  | Longitude:                                 |             |  |
| failing Address:  | Method of Lat/Long (circle o    |  | one): Conventional Survey,                 |             |  |
| P.O. Box 1  | 868                             | USGS quad, Har   | USGS quad, Hand-held GPS, Survey-grade GPS |             |  |
|   |                                 |  |  |             |  |
| WOODVILLE<br>City State                                   | Zip Code                        | <u>LL</u> <sup>1</sup> / <sub>4</sub> <u>LL</u> <sup>1</sup> / <sub>4</sub> Sec_<br>Distance Direction   | 23   | •••••0      |  |
| -   |                                 | Distance Direction   | Nearest Tov                                | vn<br>I     |  |
| Felephone No. ( <u>601)</u> 870 - 59                      | 22                              | <u> </u>   | of Bullalo                                 |             |  |
| Pump Type   |                                 | E Contraction of the second seco | ower Type                                  |             |  |
| Circle one  |                                 |  | Circle one                                 | N. 10       |  |
| Air Lift Jet  | Submersible                     | Diesel Engine Gasol  | line Engine                                | Natural Gas |  |
| Bucket Piston   | Turbine                         | Electric Motor Hand  |  | Tractor PTO |  |
| Centrifugal Rotary  | Flowing Well                    |  | r (specify):                               |             |  |
| Other (specify):  |                                 | Horse Power Rating of Moto   | or: H                                      | <u>P</u>    |  |
| Date Pump Installed: 9151.                                | 2                               | Setting Depth:50   |  |             |  |
| Rated Pump Capacity:15                                    | Gallons Per Minute              | Number of Stages:  | 14   |             |  |
| Pump Test Data  | a                               |  | Antiper Mater                              | Level       |  |
| Date Well Tested: 91512                                   | 2                               |  | Circle one                                 |             |  |
| 2 -   |                                 | Air Line Electric M  | easuring Line                              | Steel Tape  |  |
| Static Water Level (A):Fe                                 | et Below Land Surface           | Other (specify):   |  |             |  |
| Pumping Water Level (B):Fee                               | et Below Land Surface           |  |  |             |  |
| Drawdown [(B) – (A)]:Fe                                   | et Below Land Surface           | For flowing well, measured   | shut in head:                              | feet        |  |
|   | Gallons Per Minute              | Well yielded 15  | GPM with a                                 | drawdown of |  |
| Test Pumping Rate: 5                                      |                                 | feet after   | . h  |             |  |