

WILKINSON
 H 2000
 10/4/77

MISSISSIPPI
 BOARD OF WATER COMMISSIONERS
 416 North State Street
 Jackson, Mississippi 39201

136

WATER WELL DRILLERS LOG

10/4/77 date well completed 1977 firm name *Reynolds & Wilkerson* county well located

LANDOWNER: *Fritz Taylor*
Pt. Mendenhall
 (mailing address)

description of formations encountered	from	to
<i>Black Clay</i>	<i>0</i>	<i>12</i>
<i>sand & gravel</i>	<i>12</i>	<i>35</i>
<i>white chalk</i>	<i>35</i>	<i>110</i>
<i>marled Chalk and</i>	<i>110</i>	<i>165</i>
<i>Coarse sand</i>	<i>165</i>	<i>177</i>

WELL LOCATION:
 sec. *6* T *3* N R *4* W
2 1/2 miles *North* of *Buffalo*
 (distance) (direction) (nearest town)

WELL PURPOSE: *Home*
 (home, irrigation, municipal, industrial)

- WELL COMPLETION DATA:
- (1) diameter (inches) *4"*
 - (2) total depth (feet) *177*
 - (3) static water level (feet) *110* below/above top of ground.
 - (4) casing *plastic bottom*
 (material) (depth)
 if telescope see back.
 (size)
 - (5) screen *5'* *172'*
 (length) (depth to top)
4' *plastic*
 (size) (material)
 - (6) pump *3/4 HP* *12*
 (HP) (yield gpm)
electric
 (type power)
 - (7) electric log *no*
 (yes or no)
 (organization running log)

(8) how well bottom plugged
wooden plug


DRILLERS REMARKS:
old 2" well
sanded up

RECEIVED

FEB 27 1978

Please
depths.

GROUND LEVEL

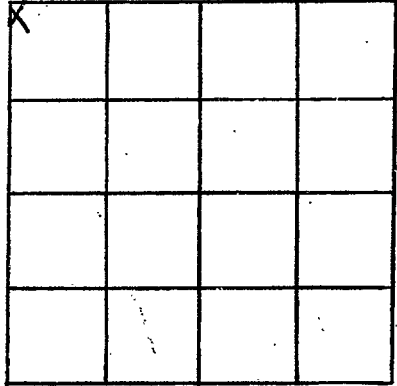

SECTION 6

Please indicate well location X.

ADDITIONAL INFORMATION

If more than one screen,
show locations of each on sketch.