

MISSISSIPPI DEPARTMENT OF NATURAL RESOURCES

Bureau of Land and Water Resources

Southport Mall

P.O. Box 10631

Jackson, Mississippi 39209

WATER WELL DRILLERS LOG

WILKINSON
H 2003

9-2
date well completed

1986 *Fl... well*
firm name

Wilkinson
county well located

LANDOWNER:	description of formations encountered	from	to
<i>Island McVaine</i>			
<i>R.R. Centerville, Ms.</i> (mailing address)	<i>Blue chalk</i>	<i>10</i>	<i>38</i>
	<i>Coarse sand</i>	<i>38</i>	<i>52</i>
WELL LOCATION:			
sec. <i>38</i> T- <i>3</i> N R- <i>1</i> E S W			
<i>12</i> miles <i>HW</i> of <i>Centerville</i> (distance) (direction) (nearest town)			
WELL PURPOSE: <i>Home</i> (home, irrigation, municipal, industrial)			
WELL COMPLETION DATA:			
(1) diameter (inches) <i>4</i>			
(2) total depth (feet) <i>52</i>			
(3) static water level (feet) <i>25</i> below above top of ground.			
(4) casing <i>42</i> , <i>42</i> (material) (depth)			
<i>4</i> (size) if telescope see back.			
(5) screen <i>10</i> , <i>42</i> (length) (depth to top)			
<i>4</i> , <i>42</i> (size) (material)			
(6) pump <i>1/2</i> , <i>10</i> (HP) (yield gpm)			
<i>Electric</i> (type power)			
(7) electric log <i>No</i> (yes or no)			
<i>...</i> (organization running log)			
(8) how well bottom plugged <i>Sand fill</i>			


RECEIVED
SEP 30 1986

Department of Natural Resources
Bureau of Land & Water Resources

DRILLERS REMARKS:

If well telescopes please sketch and show depths.

GROUND LEVEL

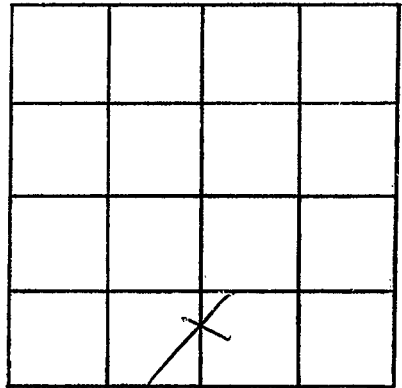

SECTION 38

Please indicate well location X.

ADDITIONAL INFORMATION

If more than one screen,
show locations of each on sketch.