

MISSISSIPPI DEPARTMENT OF NATURAL RESOURCES

Bureau of Land and Water Resources

Southport Mall

P.O. Box 10631

Jackson, Mississippi 39209

WATER WELL DRILLERS LOG

WILKINSON
H 2000

5-20 1987 River City Water Well Wilkinson
date well completed firm name county well located

LANDOWNER:
Butch Nettles
P.O. Box 160 Woodville
(mailing address) MS

WELL LOCATION:
sec. T 3 N R 1 E S 3
3 miles East of Wilkinson
(distance) (direction) (nearest town)

WELL PURPOSE: Home
(home, irrigation, municipal, industrial)

WELL COMPLETION DATA:
(1) diameter (inches) 4"
(2) total depth (feet) 200'
(3) static water level (feet) 140' below top of ground.
(4) casing PVC, 190' (material) (depth)
(size) if telescope see back.
(5) screen 10' 190' (length) (depth to top)
4" PVC (size) (material)
(6) pump 1 10 (HP) (yield gpm)
Electric (type power)
(7) electric log No (yes or no)
(organization running log) No
(8) how well bottom plugged Backwash Valve


description of formations encountered	from	to
Top Soil	0	40
Gravel	40	50
White Chalk	50	80
Blue Chalk	80	140
Chalk & Sand Mix	140	190
Fine Sand	190	190
Coarse Sand	190	200

REGISTERED
DEC 23 1987
Department of Natural Resources
Bureau of Land and Water Resources

DRILLERS REMARKS:

If well telescopes please
sketch and show depths.

GROUND LEVEL

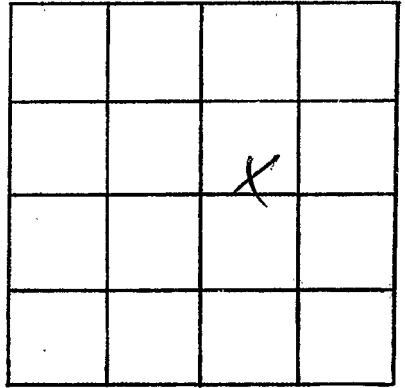

SECTION _____

Please indicate well location X.

ADDITIONAL INFORMATION

If more than one screen,
show locations of each on sketch.