

CODED

Wilkinson  
T1  
1-67

MISSISSIPPI  
BOARD OF WATER COMMISSIONERS  
416 North State Street  
Jackson, Mississippi 39201

WATER WELL DRILLERS LOG

Wilkinson

JAN 9 1967 ~~Robert H. Smith~~ KEENE'S WELL DRILLING AND  
date well completed firm name county well located

LANDOWNER: Robert H. Smith  
RFD  
Gloster  
(mailing address)

description of formations encountered	from	to
white chalk	0	15
white sand and chalk	15	35
hard white chalk	35	100
Coarse sand	100	108

WELL LOCATION:  
sec. 27 T. 3 N R. 1 E  
5 miles W of Gloster  
(distance) (direction) (nearest town)

WELL PURPOSE: Domestic  
(home, irrigation, municipal, industrial)

- WELL COMPLETION DATA:
- (1) diameter (inches) 2 1/2"
  - (2) total depth (feet) 108
  - (3) static water level (feet) 58 below above top of ground.
  - (4) casing galvanized, galvanized (material) (depth) 102  
if telescope see back.  
(size)
  - (5) screen 6' 102' (length) (depth to top)  
1/4" Plastic (size) (material)
  - (6) pump 1/2-hp 10 (HP) (yield gpm)  
Electric (type power)
  - (7) electric log no (yes or no)

CODED


(organization running log)  
(8) how well bottom plugged with screen

DRILLERS REMARKS: old wells bad



If well telescopes please sketch and show depths.

GROUND LEVEL

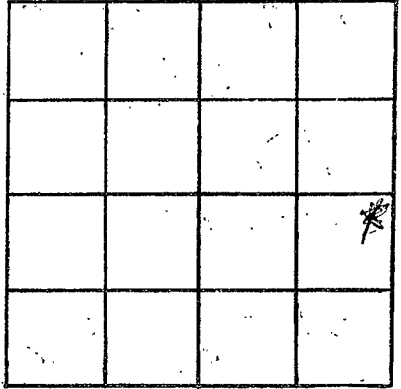

SECTION 27

Please indicate well location X.

ADDITIONAL INFORMATION

If more than one screen, show locations of each on sketch.