

WILKINSON  
 94  
 5-14-69

MISSISSIPPI  
 BOARD OF WATER COMMISSIONERS  
 416 North State Street  
 Jackson, Mississippi 39201

**CODED**

WATER WELL DRILLERS LOG

WILKINSON  
~~CRATT~~

May 14 1969 Reeves Well Pump firm name  
 date well completed county well located

LANDOWNER: Paul  
Boath  
RFDI, Slater  
 (mailing address)

description of formations encountered	from	to
yellow clay	0	21
Red Sand	21	39
Red gravel sand	37	45

WELL LOCATION:  
 sec 10 T 3 N R 1 E  
3 miles SW of Crashy  
 (distance) (direction) (nearest town)

WELL PURPOSE: Hand  
 (home, irrigation, municipal, industrial)

- WELL COMPLETION DATA:
- diameter (inches) 4"
  - total depth (feet) 45
  - static water level (feet) 3 1/2 below above top of ground.
  - casing Plastic Ballon  
 (material) (depth)  
 (size) if telescope see back.
  - screen 6" 49  
 (length) (depth to top)  
1" Plastic  
 (size) (material)
  - pump 3/4 hp 3  
 (HP) (yield gpm)  
Electric  
 (type power)
  - electric log No  
 (yes or no)

(organization running log)

(8) how well bottom plugged  
wooden plug

DRILLERS REMARKS:  
a had to  
make a well


**CODED**

AUG 21 1969

MISS. BD. OF  
 WATER COMM.

If well telescopes please sketch and show depths.

GROUND LEVEL

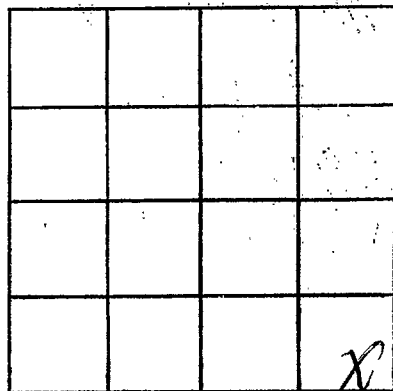

SECTION 10

Please indicate well location X.

ADDITIONAL INFORMATION

If more than one screen, show locations of each on sketch.