

WILKINSON

J6

12-22-72

MISSISSIPPI BOARD OF WATER COMMISSIONERS
416 North State Street
Jackson, Mississippi 39201

CODED

WATER-WELL DRILLERS LOG

WILKINSON
CLAYTON

Dec 22 1972
date well completed

Chester Keener
firm name

county well located

LANDOWNER:

John Smith
Rt 1, Claster

description of formations encountered

from

to

(mailing address)

WELL LOCATION:

sec. 20 T. 3 N. R. 1 E
4 miles W of Claster
(distance) (direction) (nearest town)

chert

0 15

fine sand & gravel

13 21

chert

21 30

fine sand

40 102

coarse sand

102 121

WELL PURPOSE:

Domestic
(home, irrigation, municipal, industrial)

WELL COMPLETION DATA:

- (1) diameter (inches) 4"
- (2) total depth (feet) 121
- (3) static water level (feet) 68 below top of ground
- (4) casing (material) (depth) Plast Bottom

(size) if telescope see back.

- (5) screen (length) (depth to top) 6' 115'
(size) (material) 1/2" Plast

- (6) pump (HP) (yield gpm) 1/2 Sub 17
(type power) Elect

- (7) electric log (yes or no) NO

(organization running log)

- (8) how well bottom plugged wood plug

DRILLERS REMARKS:

old well hole


CODED

MAR 10 1973

MISS. BD. OF WATER COMM.

If well telescopes please sketch and show depths.

GROUND LEVEL

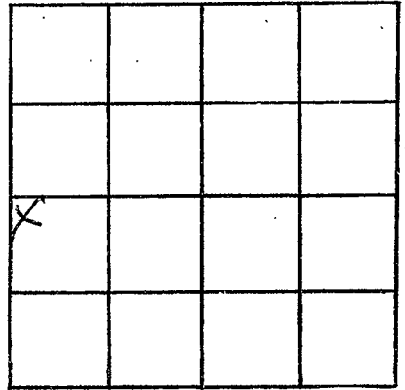

SECTION 26

Please indicate well location X.

ADDITIONAL INFORMATION

If more than one screen,
show locations of each on sketch.