

WILKINSON
J7
5-8-74

MISSISSIPPI
BOARD OF WATER COMMISSIONERS
416 North State Street
Jackson, Mississippi 39201

CODED

WATER WELL DRILLERS LOG

willkinson
~~Smith~~

May 8 1974 date well completed
Chatterbeens firm name
willkinson county well located

LANDOWNER: Robert G. Smith

Smith
Rt 1, Slatts
(mailing address)

description of formations encountered

from to

clay	0	12
blue clay	12	30
sand & gravel	30	53
blue gray chert	53	76
local sand	76	94
pea sand	94	106

WELL LOCATION:

sec. 27 T 3 N R 1 E
4 1/2 miles SW of Slatts
(distance) (direction) (nearest town)

WELL PURPOSE: house
(home, irrigation, municipal, industrial)

WELL COMPLETION DATA:

- (1) diameter (inches) 4"
- (2) total depth (feet) 106'
- (3) static water level (feet) 72' below top of ground.
- (4) casing Plast. Ballam
(material) (depth)
- (size) If telescope see back.
- (5) screen 6' 100'
(length) (depth to top)
- 4" Plast
(size) (material)
- (6) pump 1/2 HP 15
(HP) (yield gpm)
- split
(type power)
- (7) electric log NO
(yes or no)

(organization running log)

(8) how well bottom plugged
wooden plug

DRILLERS REMARKS: well had 2'


REGISTERED
RECEIVED

OCT 3/0 1974

MISS. BD. OF WATER COMM

If well telescopes please sketch and show depths.

GROUND LEVEL

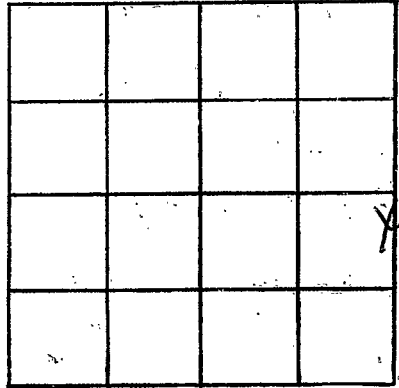

SECTION 27

Please indicate well location X.

ADDITIONAL INFORMATION

If more than one screen, show locations of each on sketch.