

MISSISSIPPI DEPARTMENT OF NATURAL RESOURCES

Bureau of Land and Water Resources

Southport Mall

P.O. Box 10631

Jackson, Mississippi 39209

WATER WELL DRILLERS LOG

CODED


WILKINSON
2015

date well completed 3/28 1986 firm name Rayborn Drig Co county well located Wilkinson

LANDOWNER:	description of formations encountered	from	to
<u>WT Drig Co</u> <u>PO Box 1487</u>	<u>Top Soil</u>	<u>0</u>	<u>10</u>
<u>Natchez MS 39120</u> (mailing address)	<u>Sand</u>	<u>10</u>	<u>50</u>
WELL LOCATION: sec. <u>7</u> T <u>3</u> (N) R <u>1</u> (E) (S) (W)	<u>Chalk</u>	<u>50</u>	<u>168</u>
<u>7</u> miles <u>SW</u> of <u>Rosetta</u> (distance) (direction) (nearest town)	<u>Sand</u>	<u>168</u>	<u>300</u>
WELL PURPOSE: <u>oilfield</u> (home, irrigation, municipal, industrial)			
WELL COMPLETION DATA:			
(1) diameter (inches) <u>3"</u>			
(2) total depth (feet) <u>300'</u>			
(3) static water level (feet) <u>130'</u> <u>below</u> top of ground.			
(4) casing <u>PVC Pipe, 290'</u> (material) (depth)	<u>344' S + 165' E of</u>		
<u>3"</u> (size) if telescope see back.	<u>NW/Cor of SW 1/4</u>		
(5) screen <u>10', 290'</u> (length) (depth to top)			
<u>3"</u> , <u>PVC Slotted Pipe</u> (size) (material)	<u>Lease Name: <u>mc</u></u> <u>Foster Creek Crosby # 1</u>		
(6) pump <u>—</u> <u>0</u> (HP) (yield gpm)			
(type power)			
(7) electric log <u>no</u> (yes or no)			
(organization running log)			
(8) how well bottom plugged <u>wood</u>			
DRILLERS REMARKS:			

If well telescopes please
sketch and show depths.

GROUND LEVEL

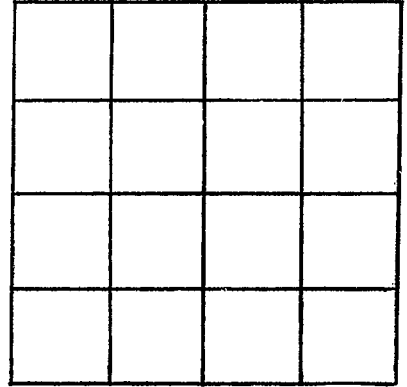

SECTION _____

Please indicate well location X.

ADDITIONAL INFORMATION

If more than one screen,
show locations of each on sketch.