

MISSISSIPPI DEPARTMENT OF NATURAL RESOURCES

Bureau of Land and Water Resources

Southport Mall

P.O. Box 10631

CODED

Jackson, Mississippi 39209

WATER WELL DRILLERS LOG

WILKERSON
T-16

325

6-4
 date well completed

1991 Morphis Bo.
 firm name

WilKerson
 county well located

LANDOWNER: Justiss Oil Co.

P.O. Box 1385

Jena, La 71342

(mailing address)

WELL LOCATION:

sec. 27 T. 3 (N) R. 1 (E)
 S W of mill
2 miles W of Gloster
 (distance) (direction) (nearest town)

WELL PURPOSE: Rig Supply
 (home, irrigation, municipal, industrial)

WELL COMPLETION DATA:

- (1) diameter (inches) 4
- (2) total depth (feet) 220
- (3) static water level (feet) 75 ^{<below} above top of ground.
- (4) casing PVC, 202,
 (material) (depth)
4 if telescope see back.
 (size)
- (5) screen 20, 202
 (length) (depth to top)
4, .020 PVC
 (size) (material)
- (6) pump 5, 60
 (HP) (yield gpm)
Elec
 (type power)
- (7) electric log NO
 (yes or no)

(organization running log)

(8) how well bottom plugged B.W.V

description of formations encountered


from

to

Sand Clay w/Gravel	0	40
White Clay	40	60
White Clay w/sd. streaks	60	80
Med Coarse Sand	80	100
White Clay	100	170
Gray Sand w/Clay Breaks	170	200
Coarse Sand	200	220

#1-27 LONG MIRE

1041'S E 783'E of NW/CR

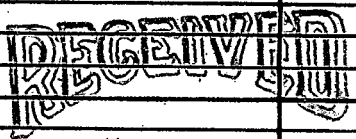


JUL 11 1991

Dept. of Environmental Quality
 Bureau of Land & Water Resources

DRILLERS REMARKS:

If well telescopes please sketch and show depths.

GROUND LEVEL

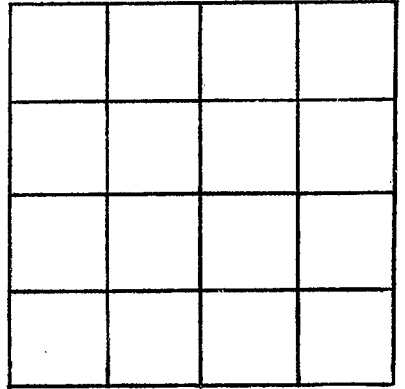

SECTION _____

Please indicate well location X.

ADDITIONAL INFORMATION

If more than one screen, show locations of each on sketch.