

MISSISSIPPI DEPARTMENT OF ENVIRONMENTAL QUALITY
Bureau of Land and Water Resources

P. O. Box 10631
Jackson, MS 39289-0631
WATER WELL DRILLERS LOG

COUNTY WELL LOCATED Wilkinson	
WELL NUMBER Longmire	CODED <input checked="" type="checkbox"/>
A # 1 - 18	
DATE WELL COMPLETED 6/22/92	

PERMIT NUMBER 0-453
NAME OF DRILLING FIRM Morphis Brothers
Trout, La 71371

NAME & MAILING ADDRESS OF LANDOWNER Oxy. USA		
P.O. Box 27570		
Houston Texas 77227		
WELL LOCATION: ' SEC	TOWNSHIP	RANGE
4	3	(N) 1 (E) S W
DISTANCE 5 Miles	DIRECTION S of	NEAREST TOWN Crosby
OTHER LANDMARK Old Depot		
WELL PURPOSE: Home, Irrigation, Municipal, Industrial, Fish Pond, etc. Rig Supply		

PUMP DATA		
PUMP TYPE (Circle One): <input checked="" type="checkbox"/> Submersible Turbine, Jet Flowing Well, Other (Describe) _____		
POWER TYPE (Circle One): <input checked="" type="checkbox"/> Electric Tractor, Diesel, Gasoline, Butane, Other (Describe) _____ H/P 5		
Pump Capacity (GPM)	No. of Stages	Setting Depth 147 FT.
PUMP TEST		
Well yielded 65 GPM with a drawdown of N/A ft. after _____ hours of pumping		

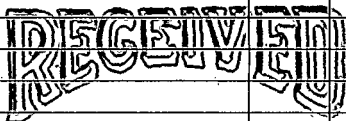
WELL DATA		
Well Depth 160	Casing Diameter (In.) 4	Casing Length (Ft.) 140
Type of Casing PVC	Hole Depth 160	Depth to Static Water Level 84
TYPE OF COMPLETION: (Circle One or More): <input checked="" type="checkbox"/> Gravel Packed Underreamed, Telescoped, Natural Development, Open Hole, Other (Describe) _____		
Top of Lap Pipe or Reduction in Casing FEET IF TELESCOPED OR MORE THAN ONE SCREEN: USE BACK PAGE		

LOG DATA	
TYPE OF LOG RUN (Circle One): No Log Run, Electric, Gamma Ray, Density, Sonic, Neutron, Other (Describe) _____	
Name of Organization Running Log	

SCREEN DATA		
Diameter - Inches 4	Length - Feet 20	Slot Size - Inches .020
Screen Type PVC	Depth to Bottom - Feet 0	

GEOLOGIC DATA (Office Use Only)			
Surface Elev.	Geologic Unit	Unit Thickness	Depth to Top
Subs. SWL	Date	Analysis	Aquifer Test

Driller's Remarks 1800' N & 1100' E of SW/40R

DESCRIPTION OF FORMATIONS ENCOUNTERED	FROM	TO	FORMATIONS (Continued)	FROM	TO
Clay-silt & Sand	0	20	 JUL 20 1992		
Sdy clay - small Gravel	20	40			
Sand & clay	46	80			
Med Coarse Brown Sand - Small Gravel	80	160			

IF MORE SPACE IS NEEDED, USE BACK

Dept. of Environmental Quality
Bureau of Land & Water Resources

If well telescopes please
sketch and show depths.

GROUND LEVEL

SECTION _____

Please indicate well location X.

ADDITIONAL INFORMATION

If more than one screen,
show location of each on sketch.