

J-23

MISSISSIPPI DEPARTMENT OF ENVIRONMENTAL QUALITY

Office of Land and Water Resources

P. O. Box 10631

Jackson, MS 39289-0631

WATER WELL DRILLERS LOG

COUNTY WELL LOCATED  
 Wilkerson  
 WELL NUMBER 29-W #1 CODED  
 Longleaf Enterprise  
 DATE WELL COMPLETED  
 2-21-04

PERMIT NUMBER  
 0-100  
 NAME OF DRILLING FIRM  
 Kauborn Drilling  
 Natchez ms 39120

NAME & MAILING ADDRESS OF LANDOWNER  
 D+D Drilling  
 P.O. Box  
 Ferriday, LA 71334  
 Latitude:  
 Longitude:  
 WELL LOCATION. SEC 28 TOWNSHIP 3 N RANGE 1 E  
 DISTANCE 5 Miles DIRECTION N of NEAREST TOWN Centerville  
 OTHER LANDMARK  
 WELL PURPOSE: Home, Irrigation, Municipal, Industrial, Fish Pond, etc.  
 Big Supply

PUMP DATA  
 PUMP TYPE (Circle One):  
 Submersible Turbine, Jet, Flowing Well,  
 Other (Describe)  
 POWER TYPE (Circle One):  
 Electric Tractor, Diesel, Gasoline, Butane,  
 Other (Describe) H/P 5  
 DESCRIPTION OF FORMATIONS ENCOUNTERED FROM TO  
 Clay 0 15  
 Clay gravel 15 80  
 Sand 80 140  
 RECEIVED  
 MAR 29 2004  
 BY: OLWF  
 Top of Lap Pipe or Reduction in Casing  
 FEET IF TELESCOPED OR MORE THAN ONE SCREEN: USE BACK PAGE

WELL DATA  
 Well Depth 140 Casing Diameter (In.) 4 Casing Length (Ft.) 120  
 Type of Casing PVC Hole Depth 140 Depth to Static Water Level 80  
 TYPE OF COMPLETION: (Circle One or More):  
 Gravel Packed Underreamed, Telescoped,  
 Natural Development, Open Hole, Other  
 (Describe)  
 WELL GROUTED TO A DEPTH OF 10 FEET  
 Type Grout (circle one): Cement Bentonite, or Mix

SCREEN DATA  
 Diameter - Inches 4 Length - Feet 20 Slot Size - Inches .020  
 Screen Type PVC Depth to Bottom - Feet 140

I certify that the well was drilled, constructed and completed in accordance with all applicable Requirements of the Mississippi Department of Environmental Quality and/or the Mississippi Department of Health regulations and state laws.


Signature of Licensed Driller and License No. 0-60

Date 3-25-04

Additional Information Required On Back

If well telescopes please sketch and show depths.

GROUND LEVEL

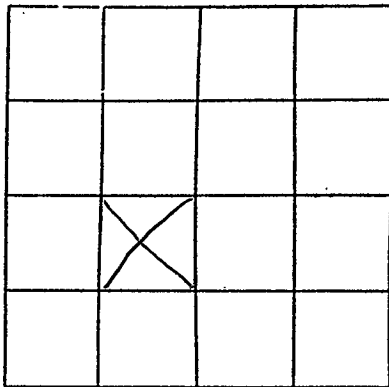

SECTION 28

Please indicate well location X.

Pump Capacity (GPM)	No. of Stages	Setting Depth	
<u>60</u>	<u>14</u>	<u>126</u>	FT.

PUMP TEST

Well yielded \_\_\_\_\_ GPM with  
a drawdown of \_\_\_\_\_ ft.  
after \_\_\_\_\_ hours of pumping

LOG DATA

TYPE OF LOG RUN (Circle One): No Log Run  
Electric, Gamma Ray, Density, Sonic, Neutron,  
Other (Describe) \_\_\_\_\_

Name of Organization Running Log \_\_\_\_\_

GEOLOGIC DATA (Office Use Only)

Surface Elev.	Geologic Unit	Unit Thickness	Depth to Top
Subs. SWL	Date	Analysis	Aquifer Test

Driller's Remarks

\_\_\_\_\_  
\_\_\_\_\_  
If more than one screen,  
show location of each on sketch.