

Wilkinson

J 2000

1-7-76

MISSISSIPPI
 BOARD OF WATER COMMISSIONERS
 416 North State Street
 Jackson, Mississippi 39201

WATER WELL DRILLERS LOG

Jan 7
date well completed

14A 76 News well Service
firm name

Wilkinson
county well located


LANDOWNER:	description of formations encountered	from	to
Ronnie Murray	Red Clay	0	20
R. F. D. Crookley (mailing address)	Red sand	20	68
	Hard blue chalk	68	165
	fine white sand	165	205
	Coarse sand & peagrand	205	223
WELL LOCATION:			
sec. <u>9</u> T. <u>3</u> N R. <u>1</u> E			
<u>1.0</u> miles <u>N</u> of <u>Centerville</u> (distance) (direction) (nearest town)			
WELL PURPOSE: <u>Home</u> (home, irrigation, municipal, industrial)			
WELL COMPLETION DATA:			
(1) diameter (inches) <u>4"</u>			
(2) total depth (feet) <u>223</u>			
(3) static water level (feet) <u>165</u> below top of ground.			
(4) casing <u>Plastic</u> <u>bottom</u> (material) (depth)			
<u> </u> If telescope see back. (size)			
(5) screen <u>6'</u> <u>217</u> (length) (depth to top)			
<u>4"</u> <u>plastic</u> (size) (material)			
(6) pump <u>3/4</u> <u>12</u> (HP) (yield gpm)			
<u>elect</u> (type power)			
(7) electric log <u>no</u> (yes or no)			
<u> </u> (organization running log)			
(8) how well bottom plugged <u>wooden plug</u>			
DRILLERS REMARKS: <u>new trailer location</u>			

APR 22 1976

MISS. RD. OF WATER COMMISSIONERS

If well telescopes please sketch and show depths.

GROUND LEVEL

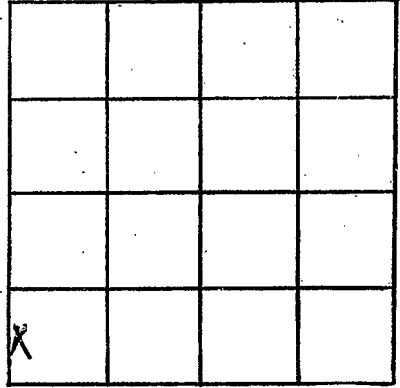

SECTION ~~47~~ 9

Please indicate well location X.

ADDITIONAL INFORMATION

If more than one screen, show locations of each on sketch.