

Wilkinson
 J 2001
 1/13/76

MISSISSIPPI BOARD OF WATER COMMISSIONERS
 416 North State Street
 Jackson, Mississippi 39201


WATER WELL DRILLERS LOG

Jan. 13 1976 *Reverwell Ser. Wilkinson*
 date well completed firm name county well located

LANDOWNER:	description of formations encountered	from	to
<i>Clarence Feltus</i> <i>Rt 1 Crosley Miss</i> (mailing address)	<i>Red clay</i>	0	20
WELL LOCATION: sec. <i>17</i> T <i>3</i> N R <i>1</i> E <i>11</i> miles <i>N-NE</i> of <i>Centerville</i> (distance) (direction) (nearest town)	<i>Red sand</i>	20	70
WELL PURPOSE: <i>Trailer</i> (home, irrigation, municipal, industrial)	<i>White Chalk</i>	70	170
WELL COMPLETION DATA:	<i>fine sand</i>	170	190
(1) diameter (inches) <i>4"</i>	<i>Coarse sand</i>	190	204
(2) total depth (feet) <i>204</i>			
(3) static water level (feet) <i>164</i> below top of ground.			
(4) casing <i>Plastic bottom</i> (material) (depth)			
(5) screen <i>6'</i> <i>198</i> (length) (depth to top)			
(6) pump <i>4"</i> <i>Plastic</i> (size) (material)			
(7) electric log <i>no</i> (yes or no)			
(8) how well bottom plugged <i>Washer plug</i>			
DRILLERS REMARKS: <i>new location</i>	<p>INSPECTED 1.00 00 1976 B.B. 1976</p> <p>MISSISSIPPI BOARD OF WATER COMMISSIONERS</p>		

If well telescopes please sketch and show depths.

GROUND LEVEL

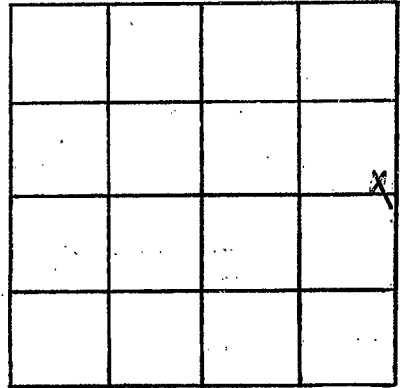

SECTION 17

Please indicate well location X.

ADDITIONAL INFORMATION

If more than one screen, show locations of each on sketch.