

MISSISSIPPI DEPARTMENT OF NATURAL RESOURCES
 Bureau of Land and Water Resources
 Southport Mall
 P.O. Box 10631
 Jackson, Mississippi 39209
WATER WELL DRILLERS LOG

Wilkinson
J 2002

3-11 1982 Rayborn Drill & Const Co. Wilkins
 date well completed firm name county well located

LANDOWNER:	description of formations encountered	from	
<u>New & Hughes</u>	<u>Top soil</u>	<u>0</u>	<u>2</u>
<u>Natchez, MS</u> <u>2 (mailing address)</u>	<u>Chault</u>	<u>2</u>	<u>4</u>
WELL LOCATION: sec. <u>21</u> T. <u>3</u> N. R. <u>1</u> E. <u>5</u> <u>SW</u>	<u>Sand</u>	<u>4</u>	<u>115</u>
(distance) _____ miles _____ of _____ (direction) _____ (nearest town)	<u>broken sand</u>	<u>115</u>	<u>220</u>
WELL PURPOSE: (home, irrigation, municipal, industrial)	<u>Chault.</u>	<u>220</u>	<u>280</u>
WELL COMPLETION DATA:	<u>Sand</u>	<u>280</u>	<u>380</u>
(1) diameter (inches) <u>3"</u>			
(2) total depth (feet) <u>380'</u>			
(3) static water level (feet) <u>120'</u> below top of ground.			
(4) casing <u>Blk</u> , <u>360'</u> (material) (depth)			
<u>3"</u> (size) if telescope see back.			
(5) screen <u>20'</u> , <u>360'</u> (length) (depth to top)			
<u>3"</u> (size) <u>slotted pipe</u> (material)			
(6) pump _____ (HP) <u>52 GPM</u> (yield gpm)			
_____ (type power)			
(7) electric log <u>no</u> (yes or no)			
_____ (organization running log)			
(8) how well bottom plugged <u>wood Plug</u>			
DRILLERS REMARKS:			

Sections 21-5


DEPT. OF NATURAL RESOURCES
 BUREAU OF LAND & WATER RESOURCES

MAR 29 1982

RECEIVED

If well telescopes please sketch and show depths.

GROUND LEVEL

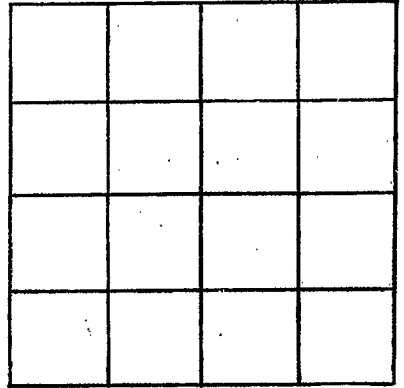

SECTION _____

Please indicate well location X.

ADDITIONAL INFORMATION

If more than one screen,
show locations of each on sketch.