

MISSISSIPPI DEPARTMENT OF NATURAL RESOURCES

Bureau of Land and Water Resources

Southport Mall

P.O. Box 10631

Jackson, Mississippi 39209

WATER WELL DRILLERS LOG

Wilkinson
8 2003

3-16 19 *82* *Rayborn Drill & Const. Co.* *Wilkinson*
 date well completed firm name county well located

LANDOWNER:
Reata
Natchez, MS
 (mailing address)

WELL LOCATION:
 sec. 1 T. 30 N. R. 10 W.
 (distance) miles (direction) of (nearest town)

WELL PURPOSE:
 (home, irrigation, municipal, industrial)

WELL COMPLETION DATA:

(1) diameter (inches) 3"

(2) total depth (feet) 315'

(3) static water level (feet) 120' below above top of ground.

(4) casing Blk 295
 (material) (depth)
3"
 (size) if telescope see back.

(5) screen 20', 295
 (length) (depth to top)
3", slotted pipe
 (size) (material)

(6) pump 52 GPM
 (HP) (yield gpm)
 (type power)

(7) electric log NO
 (yes or no)
 (organization running log)

(8) how well bottom plugged wood plug

description of formations encountered	from	to
<i>Top soil</i>	<i>0</i>	<i>2</i>
<i>Chault</i>	<i>2</i>	<i>25</i>
<i>sand</i>	<i>25</i>	<i>90</i>
<i>Chault</i>	<i>90</i>	<i>150</i>
<i>sand</i>	<i>150</i>	<i>190</i>
<i>Chault</i>	<i>190</i>	<i>250</i>
<i>sand</i>	<i>250</i>	<i>315</i>
<i>ware #1</i>		

DEPT. OF NATURAL RESOURCES
 BUREAU OF LAND & WATER RESOURCES


MAR 29 1982

RECEIVED

DRILLERS REMARKS:

If well telescopes please
sketch and show depths.

GROUND LEVEL

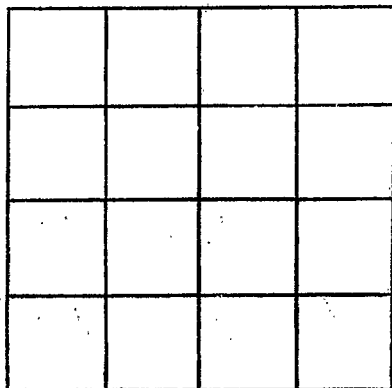

SECTION _____

Please indicate well location X.

ADDITIONAL INFORMATION

If more than one screen,
show locations of each on sketch.