

**MISSISSIPPI DEPARTMENT OF NATURAL RESOURCES**  
 Bureau of Land and Water Resources  
 Southport Mall  
 P.O. Box 10631  
 Jackson, Mississippi 39209  
**WATER WELL DRILLERS LOG**

Wilkinson  
J 2000

Sept 21 1990 Fitzgerald Well Serv Wilkinson  
 date well completed firm name county well located

LANDOWNER: Murphy Bros  
P.O. Box Jena, La  
 (mailing address)

description of formations encountered	from	to
<u>Red clay</u>	<u>0</u>	<u>20</u>
<u>Red sand</u>	<u>20</u>	<u>63</u>
<u>White chalk</u>	<u>63</u>	<u>98</u>
<u>Coarse sand &amp; gravel</u>	<u>98</u>	<u>120</u>

WELL LOCATION:  
 sec. 28 T 3 S R 1 E  
7 miles W of Harta  
 (distance) (direction) (nearest town)

WELL PURPOSE: Rig supply  
 (home, irrigation, municipal, industrial)

- WELL COMPLETION DATA:
- (1) diameter (inches) 4
  - (2) total depth (feet) 120
  - (3) static water level (feet) 22 below top of ground.
  - (4) casing PC 100  
 (material) (depth)  
4 if telescope see back.  
 (size)
  - (5) screen 20 100  
 (length) (depth to top)  
4 PC  
 (size) (material)
  - (6) pump 5 100  
 (HP) (yield gpm)  
Elco  
 (type power)
  - (7) electric log No  
 (yes or no)
  - (8) how well bottom plugged Sand blk


**RECEIVED**  
 SEP 27 1990

Department of Natural Resources  
 Bureau of Land & Water Resources

DRILLERS REMARKS:

If well telescopes please sketch and show depths.

GROUND LEVEL

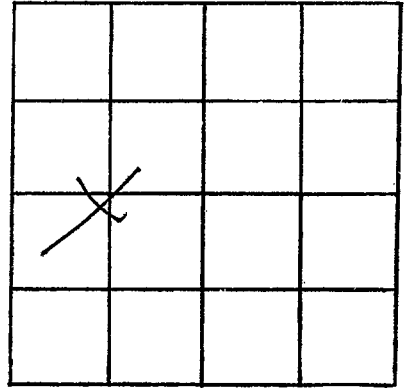

SECTION 28

Please indicate well location X.

ADDITIONAL INFORMATION

If more than one screen,  
show locations of each on sketch.