

MISSISSIPPI DEPARTMENT OF ENVIRONMENTAL QUALITY

Office of Land and Water Resources

P. O. Box 10631

Jackson, MS 39289-0631

WATER WELL DRILLERS LOG

COUNTY WELL LOCATED <i>Wilcox</i>	
WELL NUMBER <i>1</i>	CODED
DATE WELL COMPLETED <i>2011 9-23-93</i>	

PERMIT NUMBER <i>0-402</i>
NAME OF DRILLING FIRM <i>Tom Griffith</i>
<i>Water Well</i>

NAME & MAILING ADDRESS OF LANDOWNER <i>OXY USA INC</i>		
<i>PO BOX 27570</i>		
<i>Houston TX 77227</i>		
WELL LOCATION: SEC	TOWNSHIP	RANGE
<i>9</i>	<i>3</i>	<i>N 1 W</i>
DISTANCE	DIRECTION	NEAREST TOWN
<i>5</i> Miles	<i>SE</i>	<i>Crosby</i>
OTHER LANDMARK		
WELL PURPOSE: Home, Irrigation, Municipal, Industrial, Fish Pond, etc. <i>Rig Supply</i>		

PUMP DATA		
PUMP TYPE (Circle One): <input checked="" type="radio"/> Submersible, <input type="radio"/> Turbine, <input type="radio"/> Jet <input type="radio"/> Flowing Well, Other (Describe) _____		
POWER TYPE (Circle One): <input checked="" type="radio"/> Electric, <input type="radio"/> Tractor, <input type="radio"/> Diesel, <input type="radio"/> Gasoline, <input type="radio"/> Butane, Other (Describe) _____ H/P <i>5</i>		
Pump Capacity (GPM) <i>50</i>	No. of Stages	Setting Depth <i>231</i> FT.
PUMP TEST		
Well yielded _____ GPM with a drawdown of _____ ft. after _____ hours of pumping		

Well Depth <i>255</i>	Casing Diameter (In.) <i>4</i>	Casing Length (Ft.) <i>235</i>
Type of Casing <i>PVC</i>	Hole Depth <i>255</i>	Depth to Static Water Level <i>145</i>
TYPE OF COMPLETION: (Circle One or More): <input checked="" type="radio"/> Gravel Packed, <input type="radio"/> Underreamed, <input type="radio"/> Telescoped, <input type="radio"/> Natural Development, <input type="radio"/> Open Hole, <input type="radio"/> Other (Describe) _____		

LOG DATA	
TYPE OF LOG RUN (Circle One): <input type="radio"/> Electric, <input type="radio"/> Gamma Ray, <input type="radio"/> Density, <input type="radio"/> Sonic, <input checked="" type="radio"/> No Log Run, <input type="radio"/> Neutron, Other (Describe) _____	
Name of Organization Running Log	

WELL GROUTED TO A DEPTH OF <i>10</i> FEET Type Grout (circle one): Cement, Bentonite, or Mix

GEOLOGIC DATA (Office Use Only)			
Surface Elev.	Geologic Unit	Unit Thickness	Depth to Top
Subs. SWL	Date	Analysis	Aquifer Test

SCREEN DATA		
Diameter - Inches <i>4</i>	Length - Feet <i>20</i>	Slot Size - Inches <i>.025</i>
Screen Type <i>PVC</i>	Depth to Bottom - Feet <i>0</i>	


Driller's Remarks

DESCRIPTION OF FORMATIONS ENCOUNTERED	FROM	TO
<i>Fill Sand</i>	<i>0</i>	<i>10</i>
<i>Clay</i>	<i>10</i>	<i>30</i>
<i>Sand</i>	<i>30</i>	<i>45</i>
<i>Clay</i>	<i>45</i>	<i>70</i>
<i>Sand</i>	<i>70</i>	<i>145</i>
<i>CLAY</i>	<i>145</i>	<i>180</i>
<i>Sand & GRAVEL</i>	<i>180</i>	<i>255</i>

FORMATIONS (Continued)	FROM	TO
RECEIVED		
SEP 17 1993		
Dept. of Environmental Quality Office of Land & Water Resources		
IF MORE SPACE IS NEEDED, USE BACK		

If well telescopes please
sketch and show depths.

GROUND LEVEL

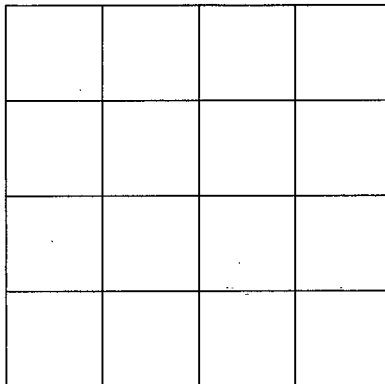

SECTION _____

Please indicate well location X.

ADDITIONAL INFORMATION

If more than one screen,
show location of each on sketch.