

# WILK. WATER WELL DRILLERS LOG

~~K-300~~

K1

Date: 8-10, 1960, Driller: Herring Derrick Co. County: Franklin  
8-10-60 (Name) WILKINSON

(1) Owner of Land: Kathleen O'Fallen  
(Name)  
  
(Address)  
  
(2) Location: 1/4, 1/4, Sec. 4, T11R1W  
12 miles N.W. of Woodville  
(distance) (direction) (Nearest Town)  
  
(3) Topography: FLAT  
(Hilly) (Flat) (Level)  
  
(4) Purpose of Well: Domestic  
(Domestic Irrigation  
Municipal, Industrial, Other)


Description & Color of Materials Sand, Clay, Red Clay, Shell, etc.	Thick- ness Feet	Depth Feet
<u>Clay</u>	<u>186'</u>	<u>186'</u>
<u>Sand</u>	<u>20'</u>	<u>206'</u>

CODED

### Information upon completion of well:

(1) Diameter 4 3/4" inches.  
(2) Total Depth 206' feet.  
(3) Water Level 22' feet below top of ground.  
(4) Cased to 201', Size 2"  
(5) Screen: Size 2", Length 5'  
(6) Were any formations sealed against pollution?  
   yes,  no.

If YES depth of formation \_\_\_\_\_  
Why \_\_\_\_\_  
Drillers Remarks: \_\_\_\_\_

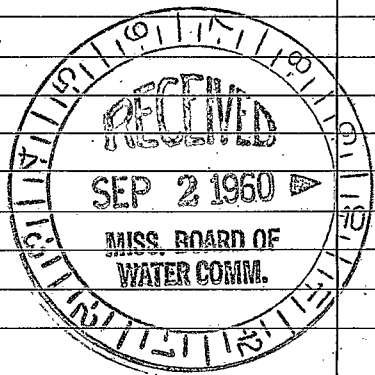

(Use Back Side)

Well No.

1948

1949

1950

1965