

CODED

29

7 7 1/2 1/4  
CODED

Wilkinson
K2
8-68

MISSISSIPPI  
BOARD OF WATER COMMISSIONERS  
416 North State Street  
Jackson, Mississippi 39201

WATER WELL DRILLERS LOG

8-29-68 date well completed  
Griner water works Wilkinson firm name  
county well located

LANDOWNER:  
*Mrs. Milton Plitt*

description of formations encountered	from	to
<i>top soil</i>	<i>0</i>	<i>2</i>
<i>Chalk</i>	<i>2</i>	<i>40</i>
<i>sand</i>	<i>40</i>	<i>315</i>
<i>Chalk</i>	<i>315</i>	<i>321</i>
<i>Coarse Sand</i>	<i>321</i>	<i>383</i>

(mailing address)

WELL LOCATION:  
sec *36* T. *3* N R. *4* E  
S *West* *East*  
*10* miles *East* of *Ledlie*  
(distance) (direction) (nearest town)

WELL PURPOSE: *Home*  
(home, irrigation, municipal, industrial)

WELL COMPLETION DATA:

(1) diameter (inches) *2"*

(2) total depth (feet) *383'*

(3) static water level (feet) *10'* <sup>below</sup> <sub>above</sub> top of ground.


(4) casing *Galv.* *378'*  
(material) (depth)  
*2"* if telescope see back.  
(size)

(5) screen *5'* *378'*  
(length) (depth to top)  
*2"* *S.S.*  
(size) (material)

(6) pump *1/2* *4*  
(HP) (yield gpm)  
*electric*  
(type power)

(7) electric log *no*  
(yes or no)  
  
(organization running log)


(8) how well bottom plugged *wood plug*

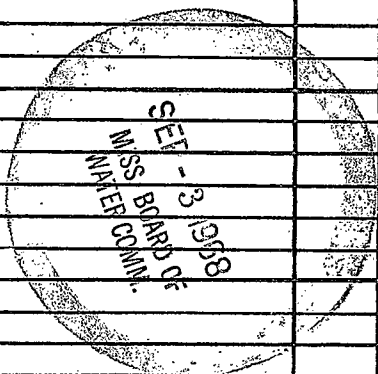

DRILLERS REMARKS:

If well telescopes please sketch and show depths.

GROUND LEVEL

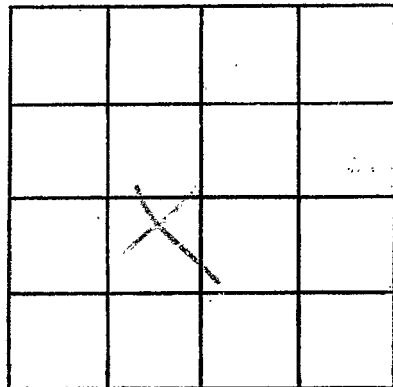

SECTION 36

Please indicate well location X.

ADDITIONAL INFORMATION

If more than one screen, show locations of each on sketch.