

Wilkinson
K 5
7-15-70

MISSISSIPPI
 BOARD OF WATER COMMISSIONERS
 416 North State Street
 Jackson, Mississippi 39201

CODED

WATER WELL DRILLERS LOG

7-15 1970 James Waterwell Wilkinson
 date well completed firm name county well located

LANDOWNER:	description of formations encountered	from	to
<u>P.M. Stricker</u> <u>Woodville, Miss</u> (mailing address)			
	<u>clay</u>	<u>2</u>	<u>30'</u>
	<u>Sand</u>	<u>30'</u>	<u>130'</u>
	<u>Shale</u>	<u>130'</u>	<u>280'</u>
	<u>sand</u>	<u>220'</u>	<u>220'</u>
	<u>Shale</u>	<u>220'</u>	<u>385'</u>
	<u>Sand</u>	<u>385'</u>	<u>400'</u>
WELL LOCATION: sec <u>46</u> T <u>2</u> (N) R <u>4</u> (E) S W			
<u>in</u> miles of <u>Fort Adams</u> (distance) (direction) (nearest town)			
WELL PURPOSE: (home, irrigation, municipal, industrial)			
WELL COMPLETION DATA:			
(1) diameter (inches) <u>2"</u>			
(2) total depth (feet) <u>400'</u>			
(3) static water level (feet) <u>20'</u> below top of ground.			
(4) casing <u>Galv.</u> <u>390'</u> (material) (depth)			
<u>2"</u> if telescope see back. (size)			
(5) screen <u>10'</u> <u>390'</u> (length) (depth to top)			
<u>2"</u> <u>"SS"</u> (size) (material)			
(6) pump <u>2</u> <u>76 GPM</u> (HP) (yield gpm)			
<u>slu</u> (type power)			
(7) electric log <u>no</u> (yes or no)			
(organization running log)			
(8) how well bottom plugged <u>wood plug</u>			
DRILLERS REMARKS:			


CODED

JUL 22 1970

MISS. BD. OF
 WATER COMM.

If well telescopes please sketch and show depths.

GROUND LEVEL

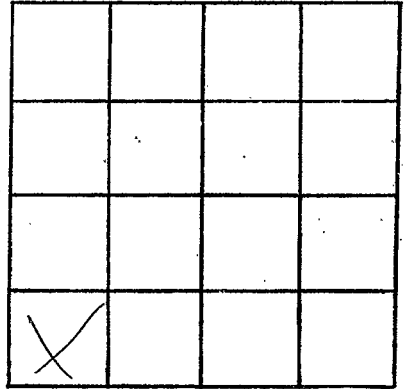

SECTION 46

Please indicate well location X.

ADDITIONAL INFORMATION

If more than one screen,
show locations of each on sketch.