

WILKINSON

K8

5-29-75

E Log # 190

5-24

1975

MISSISSIPPI BOARD OF WATER COMMISSIONERS 416 North State Street Jackson, Mississippi 39201 CODED

WATER WELL DRILLERS LOG

date well completed

firm name

county well located

Rayhorn Drilling & Const. Co. Wilkinson

LANDOWNER:

Old River Water Assn.

Wilkinson County (mailing address)

WELL LOCATION:

sec. 5 T. 2 N. R. 4 E. 10 miles SW of Woodville (distance) (direction) (nearest town)

WELL PURPOSE:

(home, irrigation, municipal, industrial)

WELL COMPLETION DATA:



- (1) diameter (inches) 12"
(2) total depth (feet) 590'
(3) static water level (feet) 290' below top of ground.
(4) casing WF 480' (material) (depth) 8" (size) If telescope see back.
(5) screen 40' 480' (length) (depth to top) 6" 55" (size) (material)
(6) pump 30 200 GPM (HP) (yield gpm) elec. (type power)
(7) electric log yes (yes or no) Mrs. Geological Survey (organization running log)
(8) how well bottom plugged Lead Seal

description of formations encountered

from to

Table with 2 columns: description of formations encountered, from, to. Rows include Top Soil, Red clay, Gray clay, Sand & Gravel, Blue clay, Sand, clay, Sand, clay, coarse sand.

CODED

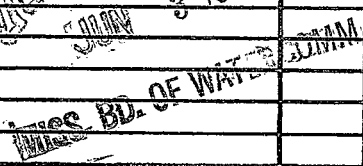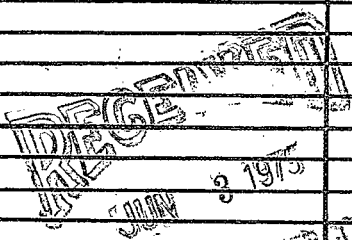

DRILLERS REMARKS:

