

MISSISSIPPI DEPARTMENT OF NATURAL RESOURCES

Bureau of Land and Water Resources

Southport Mall

P.O. Box 10631

Jackson, Mississippi 39209

WATER WELL DRILLERS LOG

CODED


WILKINSON  
K 21  
4-15-81

4-15 1981 Rayloorn Drill & Const. Co. Wilkinson  
date well completed firm name county well located

415' S & 2173' W of NE Cor.

LANDOWNER:	description of formations encountered	from	to
<u>B. A. Gortenterry</u> <u>Notches, MS</u> (mailing address)			
WELL LOCATION: sec. <u>46</u> T. <u>2</u> N. R. <u>4</u> E. <u>1/2</u> miles <u>N</u> of <u>Fort Adams</u> (distance) (direction) (nearest town)	<u>Shale</u>	<u>5</u>	<u>114</u>
WELL PURPOSE: (home, irrigation, municipal, industrial)	<u>lime sand.</u>	<u>114</u>	<u>120</u>
WELL COMPLETION DATA: (1) diameter (inches) <u>3"</u> (2) total depth (feet) <u>670'</u> (3) static water level (feet) <u>50'</u> below above top of ground. (4) casing <u>Blk. 670'</u> (material) (depth) <u>3"</u> (size) if telescope see back. (5) screen _____ (length) _____ (depth to top) (size) (material) (6) pump <u>60</u> (HP) (yield gpm) (type power) (7) electric log <u>no</u> (yes or no) (organization running log) (8) how well bottom plugged <u>Wood Plug</u>	<u>Shale</u>	<u>120</u>	<u>375</u>
	<u>lime sand</u>	<u>375</u>	<u>382</u>
	<u>Shale</u>	<u>382</u>	<u>558</u>
	<u>Sand</u>	<u>558</u>	<u>564</u>
	<u>Shale</u>	<u>564</u>	<u>570</u>
	<u>Sand</u>	<u>570</u>	<u>576</u>
	<u>Shale</u>	<u>576</u>	<u>585</u>
	<u>Sand</u>	<u>585</u>	<u>600</u>
	<u>Shale</u>	<u>600</u>	<u>604</u>
	<u>Sand</u>	<u>604</u>	<u>670</u>


Slotted pipe  
650' - 670'

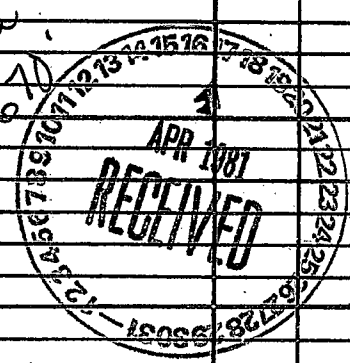

DRILLERS REMARKS: \_\_\_\_\_

If well telescopes please  
sketch and show depths.

GROUND LEVEL

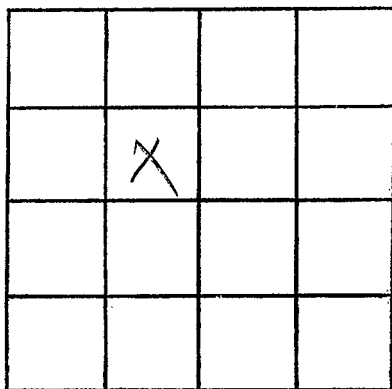

SECTION 46

Please indicate well location X.

ADDITIONAL INFORMATION

If more than one screen,  
show locations of each on sketch.