

MISSISSIPPI DEPARTMENT OF NATURAL RESOURCES

Bureau of Land and Water Resources

Southport Mall

P.O. Box 10631

Jackson, Mississippi 39209

WATER WELL DRILLERS LOG

CODED

WILKINSON
R 22
8-17-81

8-17 1981 date well completed Rayborn Drilling & Const. Co. - Wilkinson firm name county well located

LANDOWNER:
 B.H. Fortenberry
 Natchez MS 39120
(mailing address)

description of formations encountered	from	to
Top soil	0	2
gumbo	2	40
strata of sand	40	80
gumbo	80	405
sand	405	450

WELL LOCATION:
 sec. 21 T. 25 N. R. 4 E.
 4 miles NE of Fort Adams
(distance) (direction) (nearest town)

from NW Cor Sec. 27
 80 N 277' Th E 2200'

WELL PURPOSE:
(home, irrigation, municipal, industrial)

- WELL COMPLETION DATA:
- (1) diameter (inches) 3"
 - (2) total depth (feet) 450
 - (3) static water level (feet) 15 below top of ground.
 - (4) casing Blk, 430,
(material) (depth)
3" if telescope see back.
(size)
 - (5) screen 20', 430
(length) (depth to top)
3", slotted pipe
(size) (material)
 - (6) pump 50 gpm
(HP) (yield gpm)
(type power)
 - (7) electric log no
(yes or no)
(organization running log)
 - (8) how well bottom plugged wood plug

DEPT. OF NATURAL RESOURCES
 BUREAU OF LAND & WATER RESOURCES


AUG 24 1981

RECEIVED

DRILLERS REMARKS:

If well telescopes please sketch and show depths.

GROUND LEVEL

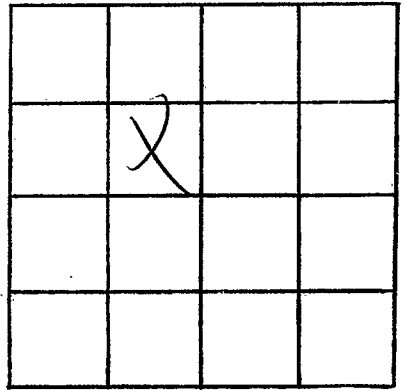

SECTION *21*

Please indicate well location X.

ADDITIONAL INFORMATION

If more than one screen,
show locations of each on sketch.