

MISSISSIPPI DEPARTMENT OF NATURAL RESOURCES

Bureau of Land and Water Resources

Southport Mall

P.O. Box 10631

Jackson, Mississippi 39209


CODED

WATER WELL DRILLERS LOG

WILKINSON
K 23
9-1-81

9-1 19 81 Rayborn Drilling & Const. Co. Wilkinson
date well completed firm name county well located


LANDOWNER:	description of formations encountered	from	to
Trace Drilling Co.	Top soil	0	2
Natcher Mrs. (mailing address)	Gumbo	2	10
WELL LOCATION:	fine sand	10	70
sec. 4 T 2 N R 4 E S 8 8 miles NW of Fordada	sand & gravel	70	90
WELL PURPOSE: (home, irrigation, municipal, industrial)	330' S + 330' E of NW Cor.		
WELL COMPLETION DATA:			
(1) diameter (inches) 2"			
(2) total depth (feet) 90'			
(3) static water level (feet) 15' below top of ground			
(4) casing 2" (size) if telescope see back.			
(5) screen 20' (length) 70' (depth to top)			
3" (size) slotted Rye (material)			
(6) pump 50 GPM (yield gpm)			
(type power)			
(7) electric log no (yes or no)			
(organization running log)			
(8) how well bottom plugged wood plug			

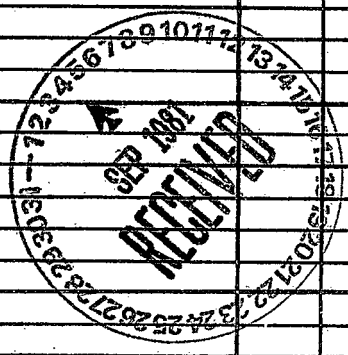

DRILLERS REMARKS:

If well telescopes please sketch and show depths.

GROUND LEVEL

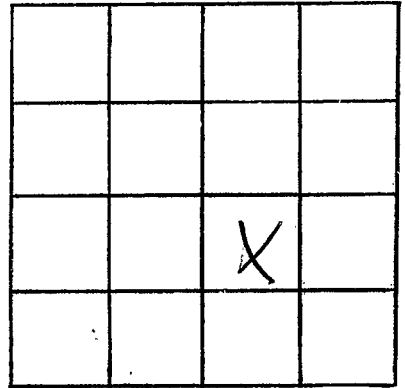

SECTION 4

Please indicate well location X.

ADDITIONAL INFORMATION

If more than one screen, show locations of each on sketch.