

MISSISSIPPI DEPARTMENT OF NATURAL RESOURCES

Bureau of Land and Water Resources

Southport Mall

P.O. Box 10631

Jackson, Mississippi 39209

WATER WELL DRILLERS LOG

CODED

WILKINSON
K24
9-1-81

9-1 1981 Rayborn Drill, & Land Co. Wilkinson
date well completed firm name county well located

LANDOWNER:	description of formations encountered	from	to
Wilcox Drillers, Inc	Top soil	0	2
Natches, MS. 39120	gumbo	2	20
(mailing address)	fine sand	20	115
	sand & gravel	115	130

WELL LOCATION:
sec. 1 T 2 N R. 4 E
10 miles NW of Ford Adams
(distance) (direction) (nearest town)

CODED

WELL PURPOSE:
(home, irrigation, municipal, industrial)

- WELL COMPLETION DATA:
- (1) diameter (inches) 3"
 - (2) total depth (feet) 130'
 - (3) static water level (feet) 15' below top of ground.
 - (4) casing Bell, 110'
(material) (depth)
3" if telescope see back.
(size)
 - (5) screen 20', 10'
(length) (depth to top)
3", Slotted Pipe
(size) (material)
 - (6) pump 52 GPM
(HP) (yield gpm)

(type power)
 - (7) electric log no
(yes or no)


(organization running log)
 - (8) how well bottom plugged wood plug



DRILLERS REMARKS:

If well telescopes please sketch and show depths.

GROUND LEVEL

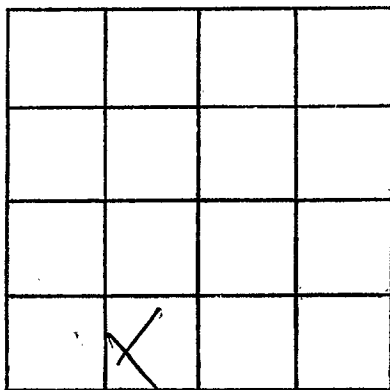

SECTION 1

Please indicate well location X.

ADDITIONAL INFORMATION

If more than one screen,
show locations of each on sketch.