

MISSISSIPPI DEPARTMENT OF NATURAL RESOURCES

Bureau of Land and Water Resources

Southport Mall

P.O. Box 10631

Jackson, Mississippi 39209

CODED

WATER WELL DRILLERS LOG

Wilkinson
Whit K 25
11-20-81

11-20
date well completed

81 Rayburn Drill & Const. Co. Wilkinson
firm name

county well located

LANDOWNER:	description of formations encountered	from	to
<u>Manchester Drilling</u> <u>Vidalia La.</u> (mailing address)	<u>top soil</u> <u>clay</u> <u>sand</u>	<u>0</u> <u>2</u> <u>60</u>	<u>2'</u> <u>60'</u> <u>120'</u>
WELL LOCATION: sec. <u>X5</u> T <u>X</u> R. <u>S</u> E <u>12</u> <u>2</u> <u>5</u> <u>W</u> (distance) (direction) (nearest town) <u>3</u> miles NW of <u>Fort Adams</u>	<u>420' S + 532' E</u> <u>of NW/Cor SESW</u>		
WELL PURPOSE: (home, irrigation, municipal, industrial)	<u>Sec. 12</u>		
WELL COMPLETION DATA: (1) diameter (inches) <u>3"</u> (2) total depth (feet) <u>120'</u> (3) static water level (feet) <u>20'</u> ^{below} above top of ground (4) casing <u>Blk</u> <u>100'</u> (material) (depth) <u>3"</u> if telescope see back. (size) (5) screen <u>20'</u> <u>100'</u> (length) (depth to top) <u>3"</u> <u>slotted pipe</u> (size) (material) (6) pump <u>5P</u> (HP) (yield gpm) <u>elec</u> (type power) (7) electric log <u>NO</u> (yes or no) (organization running log) (8) how well bottom plugged <u>wood plug</u>	<u>Smith</u> <u>Pritchett</u>	<u>CODED</u>	
DRILLERS REMARKS:			


DEPT. OF NATURAL RESOURCES
BUREAU OF LAND & WATER RESOURCES

DEC - 3 1981

RECEIVED

If well telescopes please
sketch and show depths.

GROUND LEVEL

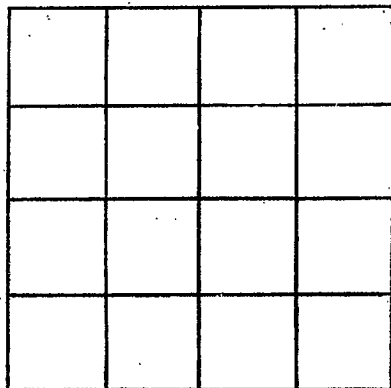

SECTION _____

Please indicate well location X.

ADDITIONAL INFORMATION

If more than one screen,
show locations of each on sketch.