

WILKINSON  
K 26  
12-2-81

MISSISSIPPI DEPARTMENT OF NATURAL RESOURCE  
Bureau of Land and Water Resources  
Southport Mall  
P.O. Box 10631  
Jackson, Mississippi 39209  
WATER WELL DRILLERS LOG

CODED

12-2-81 date well completed  
Rayborn Drill. & Const. Co. firm name  
Wilkinson county well located

LANDOWNER:  
B.H. Fortenberry  
Natchez, Ms. 39130  
(mailing address)

description of formations encountered	from	to
Top soil	0	10
Clay	10	20
Sand	20	130

WELL LOCATION:  
sec. 5 T 20 S R 5 E  
6 7 miles NW of Jodoland  
(distance) (direction) (nearest town)

WELL PURPOSE:  
(home, irrigation, municipal, industrial)

CODED

- WELL COMPLETION DATA:
- (1) diameter (inches) 3"
  - (2) total depth (feet) 130'
  - (3) static water level (feet) 20' below top of ground.
  - (4) casing (material) Blk. (depth) 110'  
3" (size) if telescope see back.
  - (5) screen (length) 20' (depth to top) 110'  
3" (size) Slotted Pipe (material)
  - (6) pump (HP) - (yield gpm) 52 GPM  
(type power)
  - (7) electric log (yes or no) no  
(organization running log)
  - (8) how well bottom plugged wired plug


Stricken 7-1  
750'S + 871'W  
of NE/Cor of Sec.

DRILLERS REMARKS:

DEPT. OF NATURAL RESOURCES  
BUREAU OF LAND & WATER RESOURCES  
DEC 10 1981  
RECEIVED

If well telescopes please sketch and show depths.

GROUND LEVEL

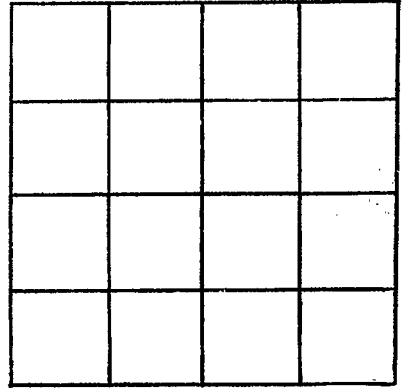

SECTION \_\_\_\_\_

Please indicate well location X.

ADDITIONAL INFORMATION

If more than one screen,  
show locations of each on sketch.