

MISSISSIPPI DEPARTMENT OF NATURAL RESOURCES
Bureau of Land and Water Resources
 Southport Mall
 P.O. Box 10631
 Jackson, Mississippi 39209
WATER WELL DRILLERS LOG

CODED

WILKINSON
K 27
Ronne
12-2-81

date well completed 12-2-81 firm name Rayburn Drill & Const. Co. Wilkinson county well located _____

LANDOWNER:
Manchester Drill. Inc.
Vidalia, La.
 (mailing address)

description of formations encountered	from	to
<u>Top soil</u>	<u>0</u>	<u>10</u>
<u>Clay</u>	<u>10</u>	<u>30</u>
<u>Sand</u>	<u>30</u>	<u>140</u>

WELL LOCATION:
 sec. 1 T 2 N R 5 E
8 miles N of Jordan
 (distance) (direction) (nearest town)

Fr NW Cor Sec. 1
1500' S + 330' E of
NW Cor

WELL PURPOSE:
 (home, irrigation, municipal, industrial)

WELL COMPLETION DATA:

(1) diameter (inches) 3"

(2) total depth (feet) 140'

(3) static water level (feet) 20' below top of ground

(4) casing Blk 120'
 (material) (depth)
2" if telescope see back.
 (size)

(5) screen 20' 130'
 (length) (depth to top)
3" Slotted Pipe
 (size) (material)

(6) pump 526GM
 (HP) (yield gpm)
 (type power)

(7) electric log —
 (yes or no)
 (organization running log)

(8) how well bottom plugged Wood Plug

77 Mgal #1 CODED


DRILLERS REMARKS:

DEPT. OF NATURAL RESOURCES
 BUREAU OF LAND & WATER RESOURCES

DEC 10 1981
RECEIVED

If well telescopes please
sketch and show depths.

GROUND LEVEL

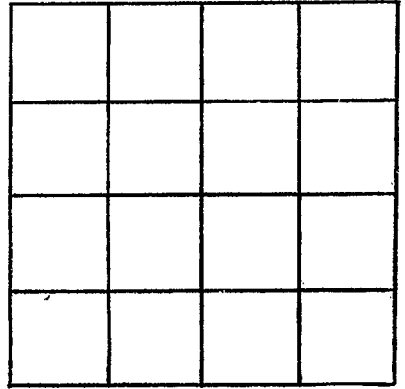

SECTION _____

Please indicate well location X.

ADDITIONAL INFORMATION

Lined area for additional information, containing a stamp: RECEIVED 31 DEC 10 4:43

If more than one screen,
show locations of each on sketch.